
U.S. PUBLIC LAND SURVEY MONUMENT RECORD

For Public Land Survey Corners in:

WI ADMINISTRATIVE CODE A-E 7.08 REQUIREMENT

T. 2N., R. // E

CORNER CODE INDEX

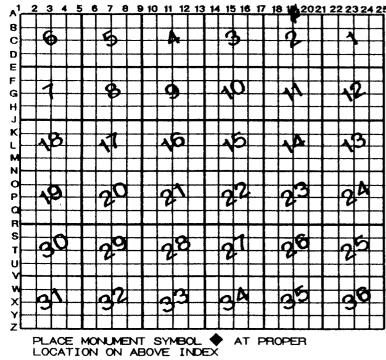

PLYM	TWI	
ROCK	COUNTY	WI

IF AVAILABLE ROCK COUNTY COORDINATES PERFERRED

North ______ Elev. _____

East _____

Hor. Datum _____ Vert. Datum _____

LATITUDE _____ ELLIPS. HT.

LONGITUTE _____ ERVERSE (X) ___

BASED ON THE FOLLOWING CONTROL:

	•	CU	HN	EK	MU	NU	MEI	4 I	
--	---	----	----	----	----	----	-----	-----	--

O WITNESS MONUMENT

BEARINGS ARE BASED ON:

(a)

FIELD BOOKPAGE #	SHEET OF _
SHOW A PLAN VIEW DRAWING DEPICTING THE CORNER MONUME PHYSICAL FEATURES, INCLUDING THE EXCAVATION AREA AND DI	
PLANNING & ZONING COMMITTEE ADOPTED THE ABOVE FORM ON 12/2/1982	er i m.

- Describe any record evidence, monument evidence, occupational evidence, testimonial evidence or any other material evidence you
- considered, and whether the monument was found or placed.


 1868 LOCKE REMONUMENTATION FIELD NOTES. INTERSECTED 1/4 LINE FOR TOWN 3. 11 LKS NORTH OF CORNER. FOUND STONE WITH STATE SET BY ANDREW CODDINGTON IN OLD MOUND. CORNER IN CENTER OF HIGHWAY AND IN LINE OF FENCE RUNNING NORTH. SET 1/4 CORNER .66' WEST OF 1/4 CORNER FOR T3N 1/4 MONUMENT MARKED WITH FIG. 2 ON SOUTH FACE. SHOWS A DISTANCE OF 2656.83 TO THE NW CORNER AND 2656.83 TO THE NE CORNER.
- 1877 RUGER VOL 2 PG 234 SHOWS A STONE MONUMENT AND STATES THAT IT IS SOUTH OF A LINE DRAWN FROM SECTION CORNER TO SECTION CORNER. SHOWS A DISTANCE OF 2654.19 TO THE NW CORNER AND 2652.54 TO THE NE CORNER. USED THE CORNER TO SUBDIVIDE SECTION 2. SHOWS A DISTANCE OF
- 2625.09 TO THE CENTER OF SECTION 2. 1933 SUNNY VOL 3 PG 235 SET 1" X 36" PIPE IN CONCRETE PAVEMENT 8.0 SOUTH OF CENTERLINE. SHOWS A DISTANCE OF 2656.9 TO THE NW CORNER AND 2656.9 TO THE NE CORNER. SHOWS A DISTANCE OF 2625.1 TO THE FENCE INTERSECTION AT THE CENTER OF SECTION 2.
- 1977 BARNES VOL 6 PG 364 FOUND SUNNY'S PIPE AND REPLACED IT WITH AN ALUMINUM MONUMENT.
- 1979 SCHROEDER VOL 5 PG 531 USED THE SOUTH QUARTER CORNER OF SECTION 35 T3N TO SUBDIVIDE SECTION 35. THAT CORNER WAS ESTABLISHED BY USING SUNNY'S PIPE.
- 1988 BARNES A-19 DUG AND FOUND CUT LIMESTONE 26" DEEP 3.0 SOUTH OF CENTER OF PAVEMENT. PLACED MAGNET ON TOP OF STONE. IT APPEARED FROM THE EXCAVATION SITE THAT SUNNY NEVER DUG FOR THE CORNER.

 1992 BARNES A-19(1) FOUND DOT DISK THAT APPEARED TO PERPETUATE THEIR
- **STATION 379+20.**

COMBS CONTACTED ME ABOUT EXISTING TIES. USED OLD OBSERVATIONS AND REDREW TIES TO CLARIFY THINGS.

- Was the corner restored through acceptance of (1) an obliterated evidence location, or, (2) a found perpetuated location? **ACCEPTED FOUND CUT LIMESTONE**.
- Describe any material discrepancy between the location of the corner as restored or reestablished and the location of that corner as previously restored or reestablished by distance and direction. discrepancy on the plan view drawing under (a), above. Show the distances between the corner as previously restored or reestablished and (1) the corner as restored or reestablished, and (2) to at least 4 of the witness monuments shown on the drawing in (a), above. DOT DISK DOES IS NOT IN THE SAME POSITION AS THE FOUND CUT LIMESTONE.
- DID NOT ACCEPT DISK. Was the corner reestablished through lost corner proportionate
- methods? If so, show the method, including the directions and distances to other public land survey corners used as evidence or used for proportioning the corner location.
- I, Donald Barnes, hereby certify that the corner points as identified by the corner code index were, in a field survey, established, reestablished, monumented, re-monumented, recovered or restored as expressed below and in conformance with the regulations and rules as required in the current manual of survey instructions of the United States Department of Interior, Bureau of Land Management.

		COUNTY SURVEYOR FILING DATA
seal		Date of computer entry
Inald Barne,	1	Date microfilmed Number of included sheets 2
07/10/00	AFFIX YOUR LAND	CORNER CODE A19(2) SURVEYOR SEAL (3)

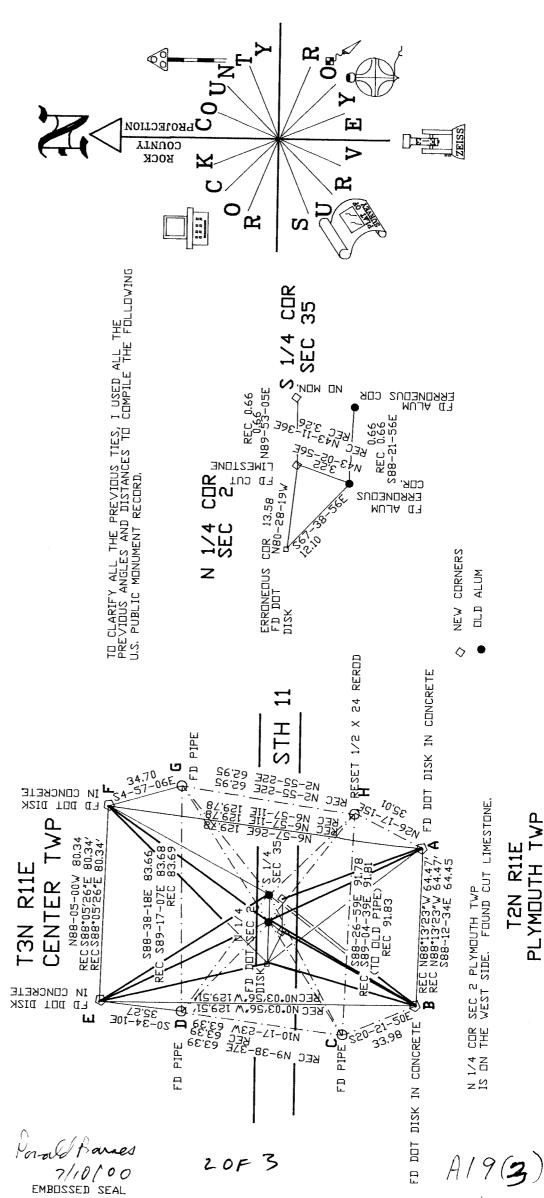

Donel Barnes

EMBOSSED SEAL

SEC COR \$ 1/4 ERRONEDUS മ Σ ALUM.

35

N23-00-52W 67.02 N32-38-34E 70.88 N60-34-50E 57.29 57.29 S60-56-12W 57.27 S48-15-39E 79.67 S28-47-59W 79.15 S31-58-29W 79.15 S54-02-47W 55.47 S53-26-04W 55.46 55.46 N54-00-23W 51.56 N58-35-21W 51.58 51.57 51.58

CU

TO N 1/4 COR SEC

LIMESTONE

N25-02-20W 65.52 N32-36-47E 68.08 N62-17-12E 54.81 S45-14-30E 52.38 S27-03-06E 81.01 S32-01-32W 81.93 S53-04-53W 58.09 N57-05-57W 51.49

▼
MUDHFQI

TO ME

T

TO OLD ALUM, MON, ERRONEOUS N 1/4 COR SEC 2

RECORD

@

N25-33-09V 65.81 N32-08-05E 67.74 N61-56-41E 54.23 S44-44-37E 51.90 S26-38-26E 80.70 S32-25-20W 80.77 S53-29-01V 58.61 N57-28-34W 52.06

AWOUMFOX

N25-32-52W 65.84 N32-07-16E 67.78 N61-55-02E 54.25 54.26 N61-14-59E 54.26 54.58 \$24-45-56E 51.87 51.90 N32-25-45E 82.25 N32-25-45E 82.25 S53-30-00W 58.59; S52-52-54W 58.5958.58 N58-03-15W 52.12; 52.03

TO CLARIFY ALL THE PREVIOUS TIES, I USED ALL THE PREVIDUS ANGLES AND DISTANCES TO COMPILE THE FOLLOWING U.S. PUBLIC MONUMENT RECORD.

SE Ā 2671.2 FROM DOT DISK TO DOT DISK RON COMBS REPORTED DISTANCE OF

3 SEC

COR

∢ mu⊩ 30F 3

N22-59-18W 67.06 N32-37-39E 70.91 N60-54-04E 57.29 S48-18-07E 51.88 S28-48-55E 79.64 S31-59-30W 79.10 S54-05-12W 55.44 N53-57-14W 51.57

TOURDUMD

TO ERRONEOUS DOT D N31-44-37W 75.23 N21-50-34E 66.76 S20-18-40E 72.01 S40-27-38E 85.22

RECORD N31-44-53E 7 N21-50-46E 6 S20-18-40E 7; S40-27-14W 8

DISK

RECORD

TO S 1/4 COR SEC 35 NEW POSITION-NO MON.

N22-28-00W 66.80 N33-04-26W 71.27 N61-13-04E 57.86 S48-47-00E 52.37 S29-13-48E 79.96 S31-35-06W 54.91 N53-31-00W 54.91 N53-31-00W 51.03

TOLUCE

N60-34-50E 57,87 S49-25-18E 52,38 N22-28-50W 66,78 N33-05-18E 71,26 N61-14-37E 57,86 N S48-45-43E 52,38 S29-13-32E 79,98 S31-34-07W 78,78 S53-39-04W 54,92 S

S53-01-53E 54,93 N54-09-07E 51.06

A19(3)