

# U.S. PUBLIC LAND SURVEY MONUMENT RECORD

For Public Land Survey Corners in:

WI ADMINISTRATIVE CODE A-E 7.08 REQUIREMENT

T. 2 N., R. 11 E

### CORNER CODE INDEX

A	2	3	4	5	6	7	8	9	10	11	12	13	14	15	16	17	18	19	20	21	22	23	24	25
B	6	5	4	3	2	1																		
C																								
D																								
E																								
F	1	8	9	10	11	12																		
G																								
H																								
I																								
J																								
K	18	17	16	15	14	13																		
L																								
M																								
N																								
O																								
P	19	20	21	22	23	24																		
Q																								
R																								
S																								
T	30	29	28	27	26	25																		
U																								
V																								
W																								
X	31	32	33	34	35	36																		
Y																								
Z																								

PLYMOUTH TWP  
ROCK COUNTY WI

IF AVAILABLE  
ROCK COUNTY COORDINATES PREFERRED

North \_\_\_\_\_ Elev. \_\_\_\_\_

East \_\_\_\_\_

Hor. Datum \_\_\_\_\_ Vert. Datum \_\_\_\_\_

LATITUDE \_\_\_\_\_ ELLIPS. HT. \_\_\_\_\_

LONGITUDE \_\_\_\_\_

GPS (X) \_\_\_\_\_ TRAVERSE (X) \_\_\_\_\_

BASED ON THE FOLLOWING CONTROL:

PLACE MONUMENT SYMBOL  AT PROPER LOCATION ON ABOVE INDEX

CORNER MONUMENT

WITNESS MONUMENT

(a)

BEARINGS ARE BASED ON:

OBSERVATION SHEET 408, 4624, 7111

FIELD BOOK \_\_\_\_\_ PAGE # \_\_\_\_\_

SHEET 1 OF 3

SHOW A PLAN VIEW DRAWING DEPICTING THE CORNER MONUMENT AND SURROUNDING PHYSICAL FEATURES, INCLUDING THE EXCAVATION AREA AND DEPTH.

PLANNING & ZONING COMMITTEE ADOPTED THE ABOVE FORM ON 12/2/1982

CORNER CODE A-7(1)

PL504

(B) Describe any record evidence, monument evidence, occupational evidence, testimonial evidence or any other material evidence you considered, and whether the monument was found or placed.

- 1833 MULLETT WEST ON SOUTH SIDE SECTION 32  
2640 SET QUARTER SECTION POST IN PRAIRIE AND MADE MOUND.  
5280 SET POST CORNER SECTIONS 31 & 32 IN PRAIRIE AND MADE MOUND LAND LEVEL FIRST RATE PRAIRIE
- 1867 LOCKE VOL 1 PG 280 FD STAKE & USED IT TO SUBDIVIDE SEC 5, 2484.24 TO CENTER OF SEC 5; 5061.01 TO S ¼ COR SEC 5.
- 1867 LOCKE VOL 1 PG 307 FD PINE STAKE @ S ¼ COR SEC 32 CENTER TWP SET BY SELF. SET OAK STAKE NORTH 594' TO CENTER OF R/R TRACKS, VAR 6-50 2655.31 TO SW COR SEC 32
- 1868 LOCKE PG 52 WEST ON NORTH LINE SEC 5 VAR 7-35  
1966.14 R.R.  
2699.4 INTERSECTED ¼ LINE FOR TOWN 3 20.79' SOUTH OF COR. FOUND STAKE SET BY SELF. (SEE CO S. RECORD) IN SHOULDER OF DITCH FENCE. VAR CORRECTED 7-08  
2679.6 SET ¼ COR T2 19.8' EAST OF COR. FOR T3 19.8' BEING ½ OF THE "JOB" AT SEC. CORNERS COR 3.96' N OF FENCE  
CONTINUED WEST FROM ¼ COR WITH VAR 6-53  
5357.22 INTERSECTED WEST BOUNDARY AT COR. FOUND COR. AS SET BY SELF. SEE RECORD COUNTY SURVEYOR. COR. ON DAM 3.63' WEST OF FENCE AND 14.85' N OF LAST POST OF AND IN LINE WITH FENCE RUNNING S. MARKED ¼ MONUMENT WITH FIGURE 5 ON SOUTH FACE. SEPT 4 1868
- OWEN*  
1913 ? VOL 6 PG 386 CALLS FOR 2681.8 TO NE COR SEC 5.  
1920 BATTERMAN VOL 3 PG 102 CALLS FOR A 6X6 STONE  
1921 ELY MAP #06335 FD STONE. 2681.8 TO NE COR SEC 5, SO-08E 2449.5 TO CENTER (POST) SEC 5, WEST 14' TO S ¼ COR SEC 32, FROM S ¼ COR SEC 32 TO CENTER OF SEC 32 N1-17W 2652.5. ANGLE @ NE COR SEC 5 FROM E ¼ COR SEC 5 TO N ¼ COR SEC 5 - 89-42, ANGLE @ CENTER SEC 5 FROM N ¼ SEC 5 TO E ¼ COR SEC 5 - 92-30
- 1940 SUNNY MAP #793 FD STONE MON AT N ¼ COR SEC 5. 14' EAST OF S ¼ COR SEC 32. S ¼ COR SEC 32 TO EAST R/W OF R/R 811.8'
- 1958 BATTERMAN DSM VOL 1 PG 6 FD 1" PIPE AT S ¼ COR SEC 32 & STONE MON. AT N ¼ COR SEC 5. S ¼ COR SEC 32 IS 14' WEST OF N ¼ COR SEC 5, ANGLE AT N ¼ COR SEC 5 FROM NE COR SEC 5 TO S ¼ COR SEC 32 - 180-24-40.  
2675.36 FROM S ¼ COR SEC 32 TO CENTER SEC 32. ANGLE AT S ¼ COR SEC 32 FROM CENTER SEC 32 TO N ¼ COR SEC 5.
- 1959 BATTERMAN MAP #530 FD OUT STONE. 2667.17 TO NE COR SEC 5 & 14.00 TO S ¼ COR SEC 32 CENTER TWP. (2641.60 FROM S ¼ COR SEC 32 TO SE COR SEC 32 CENTER TWP)
- 1964 THOM DSM VOL 1 PG 110 FD 1 ½" PIPE AT S ¼ COR SEC 32. FD OUT STONE AT N ¼ COR SEC 5. 236.22 (DEED) FROM PROPERTY COR TO THE WEST TO THE S ¼ COR SEC 32. S ¼ COR SEC 32 IS THE EAST R/W LINE OF HIAWATHA LANE. S ¼ COR SEC 32 IS 14 WEST OF N ¼ COR SEC 5.
- 1964 SHIMEALL MAP #792 STONE MON @ N ¼ COR SEC 5, PIPE @ S ¼ COR SEC 32. PIPE IS 14' TO THE WEST OF L.S. 811.8 FROM EAST R/R ROW TO S ¼ COR SEC 32.
- 1966 BATTERMAN JR. VOL 4 PG 255 OUT STONE IN MONUMENT BOX. CALLS FOR 2680.76 TO NE COR SEC 5, 2451.4 TO CENTER OF SEC 5, & AN ANGLE OF 89-58-30 FROM NE COR TO CENTER OF SEC 5
- 1966 THOM MAP #7567 FD OUT L.S. N89-28-45E 2680.76 TO NE COR SEC 5, S0-32-45E 2451.40 TO CENTER OF SEC 5, FROM CENTER OF SEC 5 TO E ¼ COR SEC 5 S88-13-45E 2668.69,

Ronald Barnes

SHEET 1 OF 3 CORNER CODE A-7(1)

1-15-03

PL504

& FROM E ¼ COR SEC 5 TO NE COR SEC 5 NO-13-15W  
2558.26'

1988 BARNES VOL 6 PG 386 CALLS FOR 2680.82 TO NE COR SEC  
5.

1991 BARNES A-7 FOUND OUT LIMESTONE IN ROUND MON. BOX &  
REFERENCED SAME. TIES SHOW JUST EAST OF DEAD END  
RD & ON NORTH SIDE OF E/W FENCE.

1999 KREBS #7568 FD OUT L.S. N88-55-09E 2682.88 TO NE COR  
SEC 5, S89-19-21W 2677.77 TO NW COR SEC 5, & S1-05-54E  
2451.04 TO CENTER SEC 5.

FD OUT LIMESTONE WITH CARSONITE. FD 2" PIPE IN ROUND  
MONUMENT BOX WITH CARSONITE AT S ¼ COR SEC 32.

C) Was the corner restored through acceptance of (1) an obliterated evidence location, or, (2) a found  
perpetuated location?

ACCEPTED FOUND OUT L.S. IN ROUND MON. BOX. REFERENCED  
CORNER.

D) Describe any material discrepancy between the location of the corner as restored or reestablished  
and the location of that corner as previously restored or reestablished by distance and direction. Show  
the discrepancy on the plan view drawing under (a), above. Show the distances between the corner as  
previously restored or reestablished and (1) the corner as restored or reestablished, and (2) to at least  
4 of the witness monuments shown on the drawing in (a), above.

(E) Was the corner reestablished through lost corner proportionate methods? If so, show the method,  
including the directions and distances to other public land survey corners used as evidence or used for  
proportioning the corner location.

I, Donald Barnes, hereby certify that the corner location as identified by the corner code index  
was determined by me under my direction and control and that this U.S. Public Land Survey  
Monument Record is correct and complete to the best of my knowledge and belief.

Seal

*Donald Barnes*

Enlbas

1-15-03

SHEET 2 OF 3

CORNER CODE

**A-7(1)**

A.E. 7.08 REQUIREMENT

DEAD END

RD

CENTER TWP  
T3N R11E  
SEC 32

DID NOT SEARCH  
S70-20-38E 60.77  
REC 60.77  
60.78  
DID NOT SEARCH

S7-46-29E  
38.23  
S26-43-09E 86.47  
REC 86.47  
86.47

S38-05-28E  
40.95  
S79-28-23E  
30.95

S48-09-17E 67.60  
S40-34-36E 51.82  
S226-48-95S  
44.19

S79-27-56E 65.33  
REC 59.69  
59.69  
N17-54-33E 59.69

N29-27-56E 65.33  
N89-39-18E 13.78  
1959 BATTERMAN 14.00  
1921 ELY 14  
1913 OWEN 14  
1868 LOCKE 19.80

N5-42-22E 47.54  
N89-42-06E  
55.13

CUT LIMESTONE  
IN MON. BOX  
FD CARSONITE POST  
3/4X24 REROD  
NO PARKING  
SIGN

□  
○  
△

DID NOT SEARCH

DID NOT SEARCH


DID NOT SEARCH

DID NOT SEARCH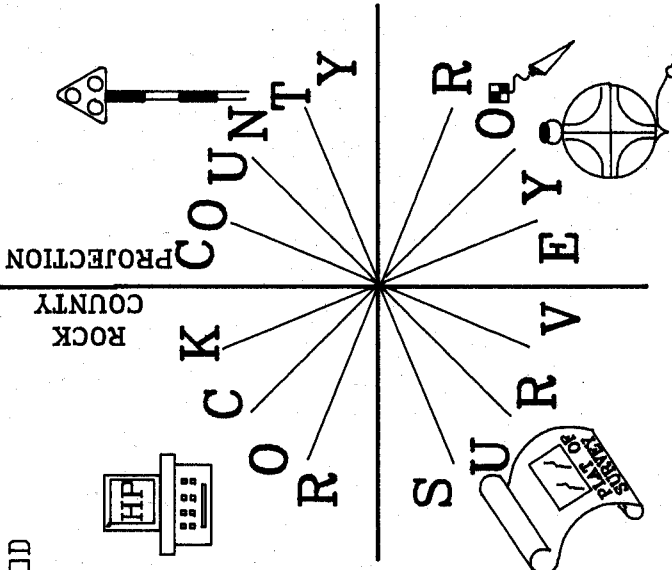

ROCK COUNTY  
PLYMOUTH TWP  
T2N R11E  
SEC 5

N89-39-18E 13.78  
1959 BATTERMAN 14.00  
1921 ELY 14  
1913 OWEN 14  
1868 LOCKE 19.80

N17-54-33E 59.69  
N29-27-56E 65.33  
N41-57-26W 53.24  
REC 53.24  
53.24

N51-20-02W 63.24  
N43-44-12E 57.50  
REC 57.50  
57.50

N32-03-39E 48.92  
N43-44-12E 57.50  
REC 57.50  
57.50

N32-03-39E 48.92  
N43-44-12E 57.50  
REC 57.50  
57.50

ZEISS  
OBSERVATION SHEETS  
103,408,504,4624,7111

PLYMOUTH TWP  
T2N R11E  
SEC 5

PLYMOUTH TWP  
T2N R11E  
SEC 5

3/4X24 REROD  
15" DEEP  
/MAGNET

N88-31-11E 75.37  
REC 75.37

N88-31-11E 75.37  
REC 75.37

Donald Barnes  
EMBOSSSED SEAL  
1/15/03

SHEET 3 OF 3

A-7(1)