U.S.


PUBLIC LAND SURVEY MONUMENT RECORD

For Public Land Survey Corners in:

WI ADMINISTRATIVE CODE A-E 7.08 REQUIREMENT

.T. 2-N., R. _//_E

CORNER CODE INDEX

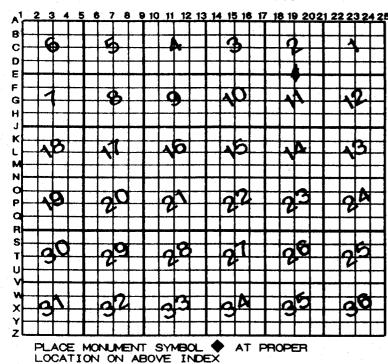

PLYMOUTH

ROCK COUNTY WI

IF AVAILABLE ROCK COUNTY COORDINATES PERFERRED

North	 	Elev.	

East

Hor. Datum _____ Vert. Datum

__ELLIPS. HT.

LONGITUTE

GPS (X) TRAVERSE (X) BASED ON THE FOLLOWING CONTROL:

♦ CORNER MONUMENT

WITNESS MONUMENT

LATITUDE

BASED EAFINGS ARE

Ż

(a)

FOR TIES 1988

OBSERVATION SHEETS 326,530,531

SHEET FIELD BOOK _ _PAGE #

SHOW A PLAN VIEW DRAWING DEPICTING THE CORNER MONUMENT AND SURROUNDING PHYSICAL FEATURES, INCLUDING THE EXCAVATION AREA AND DEPTH.

PLANNING & ZONING COMMITTEE ADOPTED THE ABOVE FORM ON 12/2/1982

CORNER CODE <u>F-19(1)</u>

(B) Describe any record evidence, monument evidence, occupational evidence, testimonial evidence or any other material evidence you considered, and whether the monument was found or placed.

1833 HARRISON EAST ON RAND. BET 2 & 11

2211 BROOK 9.9' CRS S.E.

2640 TEMPY 1/4 P

3234 LEFT MARSH & ENTER TIMBER

4158 LEFT TIMBER ENTER MARSH CRS SE

4752 LEFT MARSH ENTER TIMBER

5247.66 INT. E BDY 42.24' S DF P. LAND LEVEL & WET 3^{RD} RATE TIMBER BURR D. GRASS

COR. WEST

2620.2 QUARTER SEC COR. {BURR O 24 N61E 372.24' BURR O 24 S26E 345.84' BURR O 24 BURR O 24} MARKED

5247.66 SEC COR

- 1843 STEBBIN TWP RD REC BK 1 PG 2 VARIATION OF NEEDLE 7 1/2 BEGINNING AT THE SE COR OF SEC 1 T2N R11E; THENCE WEST 2 1/2 MILES (THIS COURSE FROM QUARTER POST ON SOUTH SIDE OF SEC 1 TO SW COR SOUTH ON A RANGE FROM BELOIT TO MADISON) TO THE QUARTER STAKE ON THE SOUTH LINE OF SEC 3; THENCE N72W ONE MILE AND 20 CHAINS TO A STAKE; THENCE 59 WEST 1079.1' TO A BURR DAK TREE; THENCE N70W 815.1' TO A STAKE; THENCE S65W 2610.3' TO A BLACK OAK TREE; THENCE \$45W 1894.2' TO SEC BETWEEN SECTIONS 5 & 8, 247.5' EAST OF THE SE COR OF SEC 6, T2N R11E; THENCE WEST FOUR MILES 3679.5' TO A STAKE ON THE SEC LINE BETWEEN SECS 4 & 9, 660' WEST OF THE QUARTER POST; THENCE N43 1/2W 838.2' TO A BURR OAK TREE; THENCE N65W 3444.54' TO A POINT ON THE LINE BETWEEN THE COUNTIES OF ROCK AND GREEN 341.88' SOUTH OF THE QUARTER POST ON THE WEST SIDE OF SEC 7, T2N, R10E AND THE WHOLE LENGTH OF THE ROAD IS 12 MILES 3927'
- 1848 TWP RD REC BK 1 PG 23 & 24 BEGINNING AT THE 1/4 POST ON THE NORTH LINE OF SEC OF 11 OF T2, R11E OF THE 4TH P.M. AND RUNNING THENCE SOUTH 3960' ON THE LINE THROUGH THE CENTER OF SEC; THENCE RUNNING S17-30W 1996.5' TO THE CENTER OF NEW BRIDGE OVER BASS CREEK AND RUNNING THENCE \$32-30W 1122' TO THE RD THROUGH THE CENTER OF THE W 1/2 OF SEC 14, SAME TWP AND RANGE. MAGNETIC VARIATION 6-30 EAST; THENCE SOUTH ON THE HALF QUARTER LINE TO THE SOUTHLINE OF SEC 14; THENCE WEST 1320' ON THE SEC LINE TO THE NW COR OF SEC 23; THENCE SOUTH ON THE SEC LINE BETWEEN COR OF SEC 23; THENCE SOUTH ON THE SOUTH LINE BETWEEN SECS 22 & 23 AND 26 AND 27,34, & 35 TO THE SOUTH LINE OF THE TOWN. SAID RD IS 66' IN WIDTH.
- 1855 CHURCH VOL 1 PG 34 STATES NOTHING ABOUT THE CORNER BUT, SHOWS DISTANCES TO IT.

1865 LOCKE FOUND STUMPS OF B. TREES.

1868 LOCKE REMONUMENTATION NOTES.

PG 36 WEST BETWEEN SEC 2 & 11 VAR 7-05

2629.11 INTERSECTED 1/4 LINE AT COR. FOUND STUMPS OF BTS AND STONE SET ON COR IN CENTER OF HIGHWAY

CONTINUED WEST WITH VAR 6-35

3072.3 EAST SIDE BRIDGE OVER BASS CREEK

SHEET 1 OF 2 CORNER CODE E-19(1)

1/14/03 Durold Raus

PL530

- 3151.5 WEST SIDE BRIDGE OVER BASS CREEK
- 5276.7 INTERSECTED WEST BOUNDARY AT COR. FOUND LARGE LIMESTONE AND STAKE UNDERNEATH IN CENTER OF HIGHWAY & IN LINE OF FENCE RUNNING NORTH. AUG 27 1868
- 1865 LOCKE VOL 1 PG 240 FD STUMPS OF BTS. USED TO SUBDIVIDE SEC 11.
- 1869 RUGER VOL 2 PG 1 FOUND MONUMENT.
- 1877 RUGER VOL 2 PG 234 SHOWS STONE MONUMENT ON MAP.
- 1938 SUNNY VOL 3 PG 391 DUG 7 X 7 X 5 DEEP AND FOUND NOTHING.
- 1988 CDMBS CSM13-292 ALUM MON. 2629.80 TO SE COR SEC 2 AN ALUM.
- 1988 BARNES E-19 I DUG AND FOUND CUT LIME STONE LEANING AT ABOUT 60 DEGREES TO THE NORTH AND STONE SPLIT LENGTH WISE IN SEVERAL PIECES. LEFT STONE IN HOLE BUT NOT NEAR THE CORNER LOCATION. PLACED ALUMINUM MONUMENT. THE CORNER IS 7' SOUTH OF THE NORTH EDGE OF THE PAVEMENT. REFERENCED SAME.
- 1988 COMBS CSM VOL 13 PG 292 FD ALUM.
- 1988 OFS CSM VOL 13 PG 355 SECTION COR. MON. (STATES NOTHING ELSE ABOUT IT)
- 1997 COMBS CSM VOL 20 PG 300 FD ALUM. MON. 2647.0X TO SW COR SEC 2.
- 1988 BARNES VOL 6 PG 379 S89-02-33W 2647.04 TO NW COR SEC 11 & N88-46-31E 2629.91 TO NE COR SEC 11
- 1988 BARNES VOL 6 PG 388 & 389 S89-19-23W 2647.04 TO SW COR SEC 2, N89-03-21E 2629.91 TO SE COR SEC 2, & N1-10-04E 2665.76 TO INT. OF 1/4 LINES, & N1-10-04E 5294.45 TO N 1/4 COR SEC 2.
- 1997 COMBS CSM VOL 20 PG 300 ALUM MON. 2647.0 TO SW COR SEC 2 A POLY.
- 1998 LATHROP CSM23-129 FD ALUM. 2629.79 TO SE COR SEC 2 & ANGLE OF 89-50-10 @ SE COR SEC 2 FROM S 1/4 COR SEC 2 TO E 1/4 COR SEC 2
- 2000 COMBS CSM VOL 24 PG 350 FD ALUM. MON.

FD TIES AND USED 1988 DBSERVATIONS

C) Was the corner restored through acceptance of (1) an obliterated evidence location, or, (2) a found perpetuated location?

ACCEPTED ALUM, MON. AS PERPETUATING CUT L.S.

I, **Donald Barnes**, hereby certify that the corner location as identified by the corner code index was determined by me under my direction and control and that this U.S. Public Land Survey Monument Record is correct and complete to the best of my knowledge and belief.

Emboss

Davold Barrer

SHEET 2 OF 2

CORNER CODE E-19(1)
A-E 7.08 REQUIREMENT