Paper weight	inimum)			8
U.S.	PUBI	IC	LAN	D S

SURVEY


MONUMENT RECORD

For Public Land Survey Corners in:

WI ADMINISTRATIVE CODE A-E 7.08 REQUIREMENT

. T. ∠N., R. ∠_E

CORNER CODE INDEX

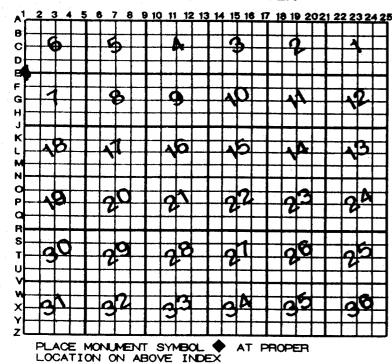

PLYMOUTH TWE

IF AVAILABLE
ROCK COUNTY COORDINATES PERFERRED

North _____ Elev. ____

Hor. Datum _____ Vert. Datum ____

LATITUDE _____ ELLIPS. HT

GPS (X) __ TRAVERSE (X) __

BASED ON THE FOLLOWING CONTROL:

♦CORNER MONUMENT

O WITNESS MONUMENT

(a) •

BEARINGS ARE BASED ON

OBSERVATION SHEETS 7106

FIELD	во	OK_		PAGE	#	•							SHEET		OF	
SHOW	A	PLAN	VIEW	DRAWING	DEPI	CTING	THE	CORN	IER	MONUM	ENT A	ND	SURRO	DUNDING	,	
PHYSIC	AL	FEA1	URES,	INCLUDIN	G THE	EXC	AVAT	ION A	REA	AND D	EPTH.					
PLANNIN	G &	ZONI	IG COM	MITTEE AD	OPTED	THE A	BOVE	FORM	ON 1	2/2/1982						

PL521 (B) Describe any record evidence, monument evidence, occupational evidence, testimonial evidence or any other material evidence you considered, and whether the monument was found or placed. 1833 MULLETT NORTH ON EAST SIDE OF SECTION 12 (T2N R 1 DE) 528 LEAVE MARSH 1584 ENTER PRAIRIE 2640 SET QUARTER SECTION POST BUR OAK 8 N7W 211.86' NO OTHER

5280 SET POST CORNER SECTION 1&12 IN PRAIRIE MADE MOUND LAND ROLLING SECOND RATE DRY PRAIRIE. BY GOOD OBSERVATION AT THIS CORNER VAR 8-15E SEPT 8^{TH} 1833

NORTH ON EAST SIDE OF SECTION 1 (T2N R10E)

2376 LEAVE PRAIRIE

2640 SET QUARTER SECTION POST BLACK DAK 16 S48W 194.04' NO OTHER

2772 ENTER MARSH

3168 LEAVE MARSH

5280 SET TEMPY 6 MILE POST. LAND ROLLING SECOND RATE SCATTERING BUR OAK PLUM, HAZEL, ASPEN

1833 HARRISON WEST BET SECS 6 & 7

2640 TE

TEMPY 1/4 P

3168 LEFT TIMBER & ENTER PRAIRIE

5287.26 INT. W. BDY 238.92' N OF P & ESTABLISHED COR TO SEC 6 & 7 $\}$ MARKED POST IN MOUND LAND ROLLING 2ND RATE WITH W.O. WALNUT CHERRY COR EAST

2647.26 QUARTER SEC COR. {W.O. 24 N11W 15.18' CHERRY 18 S14W 5.28' WO 24 CHERRY} MARKED

5287.26 SEC COR

1833 HARRISON PLAT SW TO SE COR SEC 1 5311.68

1834 MILLER EAST RANDOM BETWEEN SECS 1 & 12(T2N R10E)

5311.68 INTERSECTED RANGE LINE 3.96' N OF P. LAND LEVEL 2ND RATE

WEST CORRECTED BETWEEN SECS 1 & 12

2655.84 SET 1/4 SEC POST. BUR O 12 IN 870E 45012'?
BURR O 20 IN S83E 418.44'?

5311.68 SEC CORNER

1845 PEASE TWP RD REC BK 1 PG 7 BEGINNING AT THE SE COR OF SEC 3 IN T2N R11E RUNNING THENCE WEST ON THE SOUTH SIDE OF SEC 3 AFORESAID 5214' AND TO THE SE COR OF SEC 4, 5854.2' TO THE SE COR OF SEC 5; THENCE WEST 5272.74 ON THE SOUTH SIDE OF SEC 5; THENCE WEST 5287.26' ON THE SOUTH SIDE OF SEC 6 AND TO THE LINE BETWEEN RANGE 10 & 11; THENCE WEST 5306.4' ON THE SOUTH SIDE OF SEC 1 T2N R10E; """"" SAID RD IS 66' WIDE & 33 ' ON EACH SIDE OF THE DESCRIBED RD. VAR OF NEEDLE FOUND BY COMPARISON WITH OLD LINES. {DISTANCES MATCHORIG. GOV SURVEYOR'S DIST}

1867 LOCKE VOL 1 PG 285 FOUND POST IN MOUND. 1868 LOCKE REMONUMENTATION FIELD NOTES. PLACED CUT LIMESTONE.

PG 80 SOUTH ON WEST LINE SEC 7 VAR 7-15

2631.92 INTERSECTED 1/4 LINE AT COR. FOUND COR. AS SET BY SELF. (SEE CO. SURVEYORS RECORD SEC 7)
COR 4.29' EAST OF SOD FENCE ON EAST SIDE OF HIGHWAY AND 31.68' NORTH OF FENCE RUNNING WEST GOVT BT IS N19-45W 217.8'

5263.83 INTERSECTED SOUTH BOUNDARY AT COR. FOUND SOUTH B.T. STUMP OF NORTH B.T. AND COR AS SET BY SELF (SEE CO. S RECORD SEC 12 SPRING VALLEY) SEPT 15, 1868

PG 79 WEST BETWEEN SECS 6 AND 7 VAR -

328.02 CENTER OF BRIDGE 5.94' WIDE

SHEET 1 OF 4 CORNER CODE E-1(1)

Porald Barres 2-25-03

PL521

2655.84 INTERSECTED 1/4 LINE 4.62' NORTH OF COR. FOUND STUMPS OF B.T.S AND STAKE. NORTH BT. IS N11E VAR CORRECTED -

CONTINUED WEST FROM 1/4 COR WITH VAR -

2655.84 SET OFF 9.9' SOUTH

5334.45 INTERSECTED WEST BOUNDARY 38.94' NORTH OF COR.

VAR CORRECTED - SEPT 15 1868

PG 54 SOUTH ON WEST LINE SEC 6 VAR 7

SET OFF 9.57' EAST

2649.57 INTERSECTED 1/4 LINE 25.41' WEST OF COR. FOUND COR. AS SET BY SELF (SEE CO. SURVS RECORD FOR SEC 6 CO. IN LINE OF RAIL FENCE RUNNING E & W VAR CORRECTED 7-45

CONTINUED SOUTH WITH VAR 7-30

5240.07 INTERSECTED SOUTH BOUNDARY 7.26' WEST OF COR. FOUND STAKE IN MOUND 28.38' N OF AND IN LINE OF FENCE ON E SIDE OF HIGHWAY VAR CORRECTED 7-39 SEPT 4 186

1870 RUGER VOL 2 PG 16 & 17 FOUND STONE PLACED BY LOCKE. 1882 TWP RD REC BK 2 PG 12 COMMENCING AT THE SE COR OF SEC 1 IN THE TOWN OF SPRING VALLEY AND THE SW COR OF SEC 6, IN THE TOWN OF PLYMOUTH AND RUNNING NORTH ON THE TOWN LINE BETWEEN SAID TOWNS ABOUT THE DISTANCE OF ONE MILE TO INTERSECT A HIGHWAY RUNNING EAST & WEST ON THE NORTH LINE OF SAID TOWNS, AND THE SAME IS LAID OUT OF THE WIDTH OF 49.5'. THE SAID TOWN LINE TO BE THE CENTER OF SAID HIGHWAY FROM THE PLACE OF BEGINNING TO THE SW COR OF THE 5 ACRE LOT OWNED AND OCCUPIED BY CAROLINE HOWE AND ABOUT FORTY RODS SOUTH OF THE NORTH LINE OF SAID TOWNS, AND THE REMAINING PORTION (ABOUT 42 RODS IN LENGTH IS LAID OUT OF THE WIDTH OF 33' ON THE WEST SIDE AND OF THE WIDTH OF 16.5'; ON THE EAST SIDE OF SAID TOWN LINE WHICH SAID HIGHWAY PASSES OVER THE FOLLOWING DECRIBED LANDS OF """

1979 BARNES VOL 6 PG 1 RECORD MEASUREMENTS 1979 BARNES VOL 6 PG 7 DUG 5' DEEP AND FOUND NOTHING.

1989 BARNES E-1 DUG ANOTHER HOLE THAT IS EAST OF PREVIOUS ONE. AREA INDICATES THERE WAS A ROAD CUT. I PRORATED WITH LOCKE'S 1868 REMONUMENTATION DISTANCES FROM THE WEST QUARTER CORNER OF SECTION 6 FOR THE NORTH/SOUTH POSITION. I USED LOCKE'S DISTANCES FROM THE NORTHWEST CORNER OF SECTION 6 TO THE WEST QUARTER CORNER OF SECTION 7 AND THE NORTH LINE OF THE NORTHEAST QUARTER OF SECTION 7 FOR THE PRORATION OF THE EAST/WEST DISTANCE. THIS IS ALSO IN HARMONY WITH THE NORTH LINE OF SECTION 12 OF SPRING VALLEY. ACCEPTED OBLITERATED EVIDENCE LOCATION. SET ALUM. MON. & REFERENCED SAME. SHOWS LIMITS OF 2 EXCAVATION HOLES.

1989 BARNES VOL 6 PG 402 & 405 PLACED ALUM. N84-22-48E 2677.76 TO S ¼ COR SEC 6, SO-47-20E 2630.45 TO W ¼ COR SEC 7, & NO-12-18W 2589.05 TO W ¼ COR SEC 6.

1989 COMBS CSM14 PG 136 ALUM 2630.42 TO W $^{\prime\prime}$ COR SEC 7 1993 COMBS MAP #10004 FD ALUM. N85-10-05E 2677.73 TO N $^{\prime\prime}$ COR SEC 7 & SOUTH 2630.42 TO W $^{\prime\prime}$ COR SEC 7.

1994 LATHROP CSM 17-255&308 ALUM 2677.30 TO N 1/4 COR SEC 7 AN ALUM

1998 HOULE CSM 21-362 ALUM. 2677.76 TO S 1/4 COR SEC 6

SHEET 2 OF 4 CORNER CODE E-1(1)

Herald Barnes 2-25-03 C) Was the corner restored through acceptance of (1) an obliterated evidence location, or, (2) a found perpetuated location?

ACCEPTED ALUM. USED MY OLD OBSERVATIONS

- D) Describe any material discrepancy between the location of the corner as restored or reestablished and the location of that corner as previously restored or reestablished by distance and direction. Show the discrepancy on the plan view drawing under (a), above. Show the distances between the corner as previously restored or reestablished and (1) the corner as restored or reestablished, and (2) to at least 4 of the witness monuments shown on the drawing in (a), above.
- (E) Was the corner reestablished through lost corner proportionate methods? If so, show the method, including the directions and distances to other public land survey corners used as evidence or used for proportioning the corner location.
- I, **Donald Barnes**, hereby certify that the corner location as identified by the corner code index was determined by me under my direction and control and that this U.S. Public Land Survey Monument Record is correct and complete to the best of my knowledge and belief.

Seal

2-25-03 Donald faces

SHEET 3 OF 4

CORNER CODE E-1(1) A-E 7.08 REQUIREMENT

