U.S.


## PUBLIC LAND SURVEY MONUMENT RECORD

For Public Land Survey Corners in:

WI ADMINISTRATIVE CODE A-E 7.08 REQUIREMENT

T. 2 N., R. 1/ E

CORNER CODE INDEX

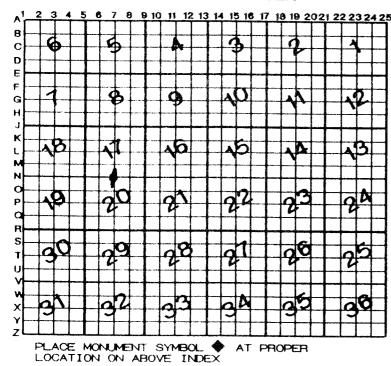

PLY	M	OUTA	4	TW	P
ROCK					

IF AVAILABLE ROCK COUNTY COORDINATES PERFERRED

North Elev
East
Hor. Datum Vert. Datum
LATITUDEELLIPS. HT.
LONGITUTE
GPS (X) TRAVERSE (X)
BASED ON THE FOLLOWING CONTROL:

**CORNER MONUMENT** 

O WITNESS MONUMENT

FOR TIES SEE N-7
[986

OBSERVATION SHEETS 31 & 9308

FIELD	BO	OK	of the second second second	_PAGE	#		-				SHEET		O
SHOW	A	PLAN	VIEW	DRAWIN	G DEP	ICTING	THE	CORNER	MONUMENT	AND	SURRO	UNDING	
PHYSIC	AL	FEAT	URES,	INCLUDI	NG TH	E EXC	AVAT	ION AREA	A AND DEPT	H.			
PLANNIN	G &	ZONIN	G COM	MITTEE A	DOPTED	THE A	BOVE	FORM ON	12/2/1982				

CORNER CODE N-7(1)

BASED ON: BEAFINGS ARE

(a)

## PL564

(B) Describe any record evidence, monument evidence, occupational evidence, testimonial evidence or any other material evidence you considered, and whether the monument was found or placed.

1833 HARRISON EAST ON RAND BET 17 & 20

1650 BROOK 3.3' CRS N.W.

2310 ENTER TIM & LEAVE MARSH

2640 TEMPY 1/4 P

5148 LEFT TIM & ENTER MARSH

5311.68 INT. E BDY 26.4' S DF P. LAND LEVEL & WET  $3^{RD}$  RATE MOSTLY MARSH – TIM BURR D.

COR. WEST

2655.84 QUARTER SEC COR. {BURR O 16 S86W 58.74' BURR O 19 S61W 47.52' BURR O 16 BURR O 29}

MARKED

5311.68 SEC COR

1867 LOCKE VOL 1 PG 286 & MAP #4375 FD S.BT & STUMP OF N.BT. & OLD STAKE – SET STAKE. VAR 7-17 ALONG N/S CENTER LINE OF SEC 20.

1868 LOCKE PG 67 EAST BETWEEN SECS 17 AND 20 VAR 7

O SET OFF 52.14' SOUTH

2677.95 INTERSECTED  ${}^{1}\!\!/_4$  LINE 6.27' NORTH OF COR. FOUND SOUTH BT AND STUMP OF WEST B.T. AND STAKE. COR. IN LINE OF N AND S FENCE AND 2.31' SOUTH OF E & W FENCE VAR CORRECTED 5-45

CONTINUED EAST FROM 1/4 COR WITH VAR 6-25

2677.95 SET OFF 3.3' NORTH

3828 SET OFF 6.27' SOUTH

4224 SET OFF 4.95' SOUTH

4422 SET OFF 14.52' SOUTH

5347.98 INTERSECTED EAST BOUNDARY 4.29' SOUTH OF COR. VAR CORRECTED 6-02 SEPT 10 1868

1869 LEE VOL 1 PG 357 FD MON. 2672.34 TO NE COR SEC 20 & VAR 8-00 2659.8 TO CENTER OF SEC 20

1979 BARNES VOL 5 PG 561 S ¼ COR SEC 18 TO S ¼ COR SEC 17 S84-25-06E 5342.90

1986 BARNES N-7 FARMER REPORTED THAT HE THOUGHT THE STONE WAS DESTROYED BY CONSTRUCTION. I FOUND THE CUT LIMESTONE, WHICH WAS FLUSH WITH THE GROUND. I PLACED A MAGNET ON THE NORTH SIDE & CARSONITE POST ON NORTH EDGE OF STONE. REFERENCED SAME. COR IS WEST OF LANE.

1994 COMBS MAP #9385 FD STONE.

1997 LATHROP MAP #8527 STATES NOTHING ABOUT MON.
2000 KREBS MAP #7598 & 7599 FD CUT STONE S88-48-19E
2669.09 TO SE COR SEC 17, NO-07-59E 2669.65 TO CEN SEC
17.

C) Was the corner restored through acceptance of (1) an obliterated evidence location, or, (2) a found perpetuated location?

FD CUT L.S. WITH R/W POST ON EAST SIDE. ACCEPTED FD L.S.

I, **Donald Barnes**, hereby certify that the corner location as identified by the corner code index was determined by me under my direction and control and that this U.S. Public Land Survey Monument Record is correct and complete to the best of my knowledge and belief.

Seal

**2-25-03** Emboss

SHEET 1 OF 1

corner code  $\,$  N-7(1) a.e. 7.08 requirement