
U.S. PUBLIC LAND SURVEY MONUMENT RECORD

For Public Land Survey Corners In:

WI ADMINISTRATIVE CODE A-E 7.08 REQUIREMENT

T. 2 N. R. // E.

CORNER CODE INDEX

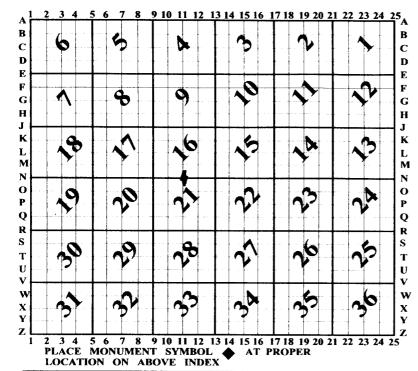

PLYMOUTH	TWI
ROCK COUNTY	WI

IF AVAILABLE ROCK COUNTY COORDINATES PERFERRED

North	Elev.
East	-
Hor. Datum	Vert. Datum
LATITUDE	ELLIPS. HT
LONGITUDE	
GPS (X)	TRAVERSE (X)
BASED ON THE F	FOLLOWING CONTROL:

♦ CORNER MONUMENT

WITNESS MONUMENT

BEARINGS ARE BASED ON:

(a)

OBSERVATION SHEET 135 \$\frac{1}{2}804

FIELD BOOK _____ PAGE # ____ OF ___

SHOW A PLAN VIEW DRAWING DEPICTING THE CORNER MONUMENT AND SURROUNDING PHYSICAL FEATURES, INCLUDING THE EXCAVATION AREA AND DEPTH. PLANNING & ZONING COMMITTEE ADOPTED THE ABOVE FORM ON 12/2/1982

PL566

(B) Describe any record evidence, monument evidence, occupational evidence, testimonial evidence or any other material evidence you considered, and whether the monument was found or placed.

1833 HARRISON EAST ON RAND. BET 16 & 21

2640 SET TEMPY 1/4 P

2838 LEFT MARSH & INTO TIMBER

3300 LEFT TIM. & ENTER MARSH

4422 LEFT MARSH & ENTER TIMBER

5265.48 INT. E BDY 17.82' N \Box F P LAND LEVEL & WET \mathbf{Z}^{ND} RATE TIMBER BURR 7 BLK \Box

COR. WEST

672.54 BURR 0 24

1971.42 BURR D 16

2632.74 QUARTER SEC COR BURR O 12 581E 264' BURR O 12 N38E 227.04'

1868 LOCKE PG 59 COMMENCED AT COR FOR SECS 15,16,21 & 22

AND RUN WEST BETWEEN SECS 16 & 21 VAR 5-55

2651.22 INTERSECTED 1/4 LINE 1.32' SOUTH OF COR.
FOUND STUMPS OF BTS. DISTANCE TO SOUTH BT
297' COR 1.32' NORTH AND 1.32' EAST OF FENCE
COR. VAR CORRECTED 5-53

CONTINUED WEST FROM 1/4 COR WITH VAR 5-30

3977.16 FENCE RUNNING N AND S

5301.78 INTERSECTED WEST BOUNDARY 17.82' NORTH OF COR. FOUND BTS SOUTH BT IS SOUTH B2 W 237.6' COR IS 6 INCHES NORTH OF CENTER OF COR POST TO FENCE VAR CORRECTED 5-53 SEPT 9 1868

1978 BARNES VOL 5 PG 496 FD CUTSTONE. ½ OF THE STONE WAS OUT OF THE GROUND & LEANING AT ABOUT A 45 ANGLE. RESET STONE AT GROUND LEVEL. @ FENCE INT. R/W POST ON WEST SIDE

- 1982 COMBS CSM VOL 10 PG 490 CUT L.S. 2645.8 TO SET R/R SPIKE @ CENTER OF SEC 21
- 1987 BARNES N-13 2651.75 TO SE COR SEC 16, ANGLE @ SE COR SEC 16 FROM E $^{\prime}4$ COR SEC 21 TO S $^{\prime}4$ COR SEC 16 IS 91-14-05, & ANGLE @ SE COR SEC 16 FROM S $^{\prime}4$ COR SEC 16 TO E $^{\prime}4$ COR SEC 16 IS 88-47-35.
- 1987 BARNES N-11 FD CUT LIMESTONE & R/W POST.
 REFERENCED SAME. STONE IS EAST OF N/S FENCE.
- 1987 COMBS CSM VOL 12 PG 612 CUT L.S. ANGLE OF 88-47-35 @ SE COR SEC 16 FROM S lambda TO E lambda COR SEC 16
- 1996 KREBS MAP #B908 FD CUT STONE. NB9-08-05W 2652.61 TO NW COR SEC 21, & SO-20-45E 2655.59 TO CEN SEC 21.

FD CUT L.S., REFERENCE MON., & R/W MON. IN WOODED RAVINE.

C) Was the corner restored through acceptance of (1) an obliterated evidence location, or, (2) a found perpetuated location?

ACCEPTED FD CUT L.S.

I, Donald Barnes, hereby certify that the corner location as identified by the corner code index was determined by me under my direction and control and that this U.S. Public Land Survey Monument Record is correct and complete to the best of my knowledge and belief.

المتات

Funtions

SHEET 1 OF 1

12-27-02

CORNER CODE N-11(1)

A.E. 7.08 REQUIREMENT