
U.S.

## LAND PUBLIC SURVEY MONUMENT RECORD

For Public Land Survey Corners in: T. 2N., R. 13 E

WI ADMINISTRATIVE CODE A-E 7.08 REQUIREMENT

CORNER CODE INDEX

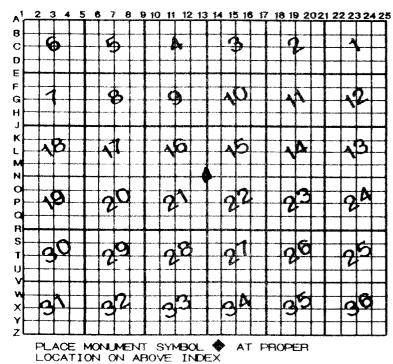

PLYMOUTH ROCK COUNTY WI

IF AVAILABLE ROCK COUNTY COORDINATES PERFERRED

North			Elev	
East				
Hor. I	Datui	m	Vert. D	atum
LATIT	UDE	-		ELLIPS. HT
LONG	TUT	E _		
GPS	(X)		TRAVER	SE (X)
BASED	ON	THE	FOLLOWING	CONTROL:

**♦** CORNER MONUMENT

WITNESS MONUMENT

FOR TIES SEE N-13

BEAFINGS ARE BASED ON

(a)

OBSERVATION SHEET 1188 802

V	•		
		<i>1</i>	2
FIELD	BOOK PAGE #	SHEET O	F
SHOW	A PLAN VIEW DRAWING DEPICTING THE CO	DRNER MONUMENT AND SURROUNDING	

PHYSICAL FEATURES, INCLUDING THE EXCAVATION AREA AND DEPTH. PLANNING & ZONING COMMITTEE ADOPTED THE ABOVE FORM ON 12/2/1982

CORNER CODE M-13(1)

## PL567

(B) Describe any record evidence, monument evidence, occupational evidence, testimonial evidence or any other material evidence you considered, and whether the monument was found or placed.

1833 HARRISON EAST ON RANDOM BET 15 & 22

1122 LEFT TIMBER & ENTER MARSH

1650 LEFT MARSH

2640 TEMPY 1/4 P

5240.4 INT. E BDY 17.82' N OF P LAND LEVEL & SOME WHAT WET  $\mathbf{2}^{\text{ND}}$  RATE WITH TIMBER OF BURR O & WHITE O COR W

2620.2 QUARTER SEC COR {BURR 0 24 N13W B2.5' BURR 0 18 S7E 44.22' BURR 0 24 BURR 0 18} MARKED

4730.88 BURR 0 12

5240.4 INT. W BDY.

EAST ON RAND. BET 16 & 21

2640 SET TEMPY 1/4 P

2838 LEFT MARSH & INTO TIMBER

3300 LEFT TIM. & ENTER MARSH

4422 LEFT MARSH & ENTER TIMBER

5265.48 INT. E BDY 17.82' N OF P LAND LEVEL & WET 2<sup>ND</sup> RATE TIMBER BURR 7 BLK O

COR. WEST

672.54 BURR 0 24

1971.42 BURR 0 16

2632.74 QUARTER SEC COR BURR O 12 581E 264' BURR O 12 N38E 227.04'

NORTH BETWEEN 15 & 16

594 BURR 0 15

924 LEFT TIMBER & ENTER MARSH

QUARTER SEC COR {BURR D 16 N4DW 201.3' BURR D 16 S52E 216.48' BURR D 14 BURR D 16}MARKED

5016 LEFT MARSH & ENTER TIMBER

5280 COR TO SECS 9 10 15 16 {BURR 0 16 N10W 66' BURR 0 24 535W 53.46' BURR 0 12 N77E 19.8' BURR 0 538E 158.4' LAND LEVEL & WET 3<sup>RD</sup> RATE MOSTLY MARSH

NORTH BET 21 & 22

1518 LEFT PRAIRIE & ENTER ? TIMBER

QUARTER SEC COR. BURR D. 10 NB7W 149.16' BURR D W.O} MARKED

2838 LEFT TIMBER & ENTER WET PRAIRIE

3630 LEFT WET PRAIRIE & ENTER ??

4382.4 BURR 0 16

5280 COR TO SECS 15 16 21 22 {BURR O 24 S49W 48.18' BURR O 20 N47W 67.98' BURR O 18 N43E 99' BUR O 19 S34E 162.36' LAND & SAME A LAST MILE

1847 TWP RD REC BK 1 PG 21BEGINNING AT THE NW COR OF SEC 3 AND 4, 9 AND 10, 15 AND 16, 21 AND 22 TO THE SW COR OF SEC 22. SAID RD IS 66' IN WIDTH

1850 MC VANE TWP RD REC BK 1 PG 28 BEGINNING AT THE NW COR OF THE EAST ½ OF THE SW ¼ OF SEC 21-T2N R11E; THENCE RUNNING EAST ON THE QUARTER LINE OF SAID SECTION 2320'; THENCE N31E 3110' TO THE SE COR OF SEC; THENCE N37 ½ 828' TO THE NW COR OF THE SE ¼ LINE OF SAID SEC 3960' TO THE NW COR OF THE SW ¼ OF SEC 14. SAID COURSE AND DISTANCES ARE THE CENTER OF THE ROAD. VARIATION OF THE MAGNETIC NEEDLE 6 EAST.

1868 LOCKE PG21 NORTH BETWEEN SEC 21 & 22 VAR 8

2662.44 INTERSECTED 1/4 LINE 22.11' WEST OF COR. FOUND STAKE AND WHERE BTS WERE DUG OUT COR IN FENCE (N&S) VAR CORRECTED 7-31

SET OFF 22.11' WEST AND CONTINUED NORTH WITH VAR 7-35

5309.7 INTERSECTED NORTH BOUNDARY 18.48' WEST OF COR.
FOUND BT IN SEC 21 AND STUMP OF BTS IN 15,16, & 22
AND OLD STAKE. VAR CORRECTED 7-40 AUG 22 1868

SHEET 1 OF 2 CORNER CODE N-13(1)

PurlBaines May 12 2003 PG 22 EAST BETWEEN SECS 15 & 22 VAR 6-37

1298.88 CENTER SMALL BRIDGE

2636.37 INTERSECTED 1/4 LINE 23.76' NORTH OF COR. FOUND STUMPS OF BTS AND WHERE STAKE WAS EVIDENTLY PULLED OUT. SOUTH BT IS \$70E COR IN CENTER OF HIGHWAY VAR CORRECTED 6-06

CONTINUED EAST FROM 1/4 COR WITH VAR 5-45

5269.11 INTERSECTED EAST BOUNDARY AT COR. FOUND BT IN SEC 22 & STUMPS OF BTS IN 14 15 23 AND STAKE BT IN 22 IS S47W 112.2' & DIST TO BT IN 23 IS 103.62' COR IN CENTER OF HIGHWAY AND IN LINE OF FENCE RUNNING NORTH VAR CORRECTED 5-45 AUG 22 186B PG 59 COMMENCED AT COR FOR SECS 15,16,21 & 22 AND RUN WEST BETWEEN SECS 16 & 21 VAR 5-55

2651.22 INTERSECTED 1/4 LINE 1.32' SOUTH OF COR. FOUND STUMPS OF BTS. DISTANCE TO SOUTH BT 297' COR 1.32' NORTH AND 1.32' EAST OF FENCE COR. VAR CORRECTED 5-53

CONTINUED WEST FROM 1/4 COR WITH VAR 5-30

3977.16 FENCE RUNNING N AND S

5301.78 INTERSECTED WEST BOUNDARY 17.82' NORTH OF COR.
FOUND BTS SOUTH BT IS SOUTH 82 W 237.6' COR IS 6
INCHES NORTH OF CENTER OF COR POST TO FENCE VAR
CORRECTED 5-53 SEPT 9 1868

PG44 NORTH BETWEEN SECS 15 & 16 VAR6-50

2640 SET TEMPORARY 1/4 COR. CO. LOST

4185.72 CENTER OF M&M RR

4686 BASS CREEK

5305.40 INTERSECTED NORTH BOUNDARY AT COR.

2652.70 SET  $\frac{1}{4}$  COR 12.71' NORTH OF TEMPORARY  $\frac{1}{4}$  COR COR JUST EAST OF N & S FENCE SEPT 3 1868

1873 RUGER VOL 2 PG 112 FD STONE MON. & MEASURED TO THE SOUTH AND WEST QUARTER CORNERS OF SEC 15.

1987 BARNES N-13 DUG & FD 1" IRON PIN. PIN IS 0.46' SOUTH & 0.08' EAST OF PRORATED POSITION. REPLACED PIN WITH POLY MON. REFERENCED SAME. COR IS ON WEST PVMT EDGE. EXCAVATION HOLE IS SHOWN. N89-39-28W 2651.75 TO S 1/4 COR SEC 16, N89-57-20E 2636.71 TO S 1/4 COR SEC 15, N0-51-53W 2654.10 TO W 1/4 COR SEC 15, & SO-53-53E 2647.72 TO E 1/4 COR SEC 21. EXCAVATION HOLE IS 4' DEEP.

1987 COMBS CSM VOL12 PG 612 ALUM. @ COR & ANGLE OF 88-47-35 @ SE COR SEC 16 FROM S 1/4 TO E 1/4 COR SEC 16 1998 COMBS MAP #8235 FD ALUM. 2636.58 TO N 1/4 COR SEC 22 1998 COMBS MAP #8060 FD IRON PIN 2654.02 TO W 1/4 COR SEC 15.

FD ALUM, ON WEST SIDE OF PVMT & REFERENCE MONUMENTS.

C) Was the corner restored through acceptance of (1) an obliterated evidence location, or, (2) a found perpetuated location?

LOCATION OF LOCKE'S PRORATION IS WELL WITHIN THE EXCAVATION HOLE. LOCKE DECLARED E 1/4 COR SEC 16 LOST. SET MIDWAY ON LINE BETWEEN SE & NE CORNERS SEC 16. THE E 1/4 COR SEC 16 IS 0.4' OFF A LINE BETWEEN THE NE & SE CORNERS SEC 16, WHICH IS IN HARMONY WITH LOCKE'S CALL. ACCEPTED FD ALUM.

I, **Donald Barnes**, hereby certify that the corner location as identified by the corner code index was determined by me under my direction and control and that this U.S. Public Land Survey Monument Record is correct and complete to the best of my knowledge and belief.

Seal

SHEET 2 OF 2

corner code N-13(1)

May 12 7003

A.E. 7.08 REQUIREMENT