## U.S.


## PUBLIC LAND SURVEY MONUMENT RECORD

For Public Land Survey Corners in:

WI ADMINISTRATIVE CODE A-E 7.08 REQUIREMENT

. T. 2N. R. \_//\_E

CORNER CODE INDEX

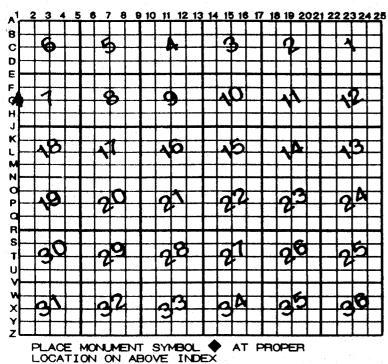

PLYMOUTH TWE

IF AVAILABLE
ROCK COUNTY COORDINATES PERFERRED

North \_\_\_\_\_ Elev. \_\_\_\_

East \_\_\_\_

Hor. Datum \_\_\_\_\_ Vert. Datum \_\_\_\_

LATITUDE \_\_\_\_\_ELLIPS. HT.

LONGITUTE

GPS (X) \_\_ TRAVERSE (X) \_\_

BASED ON THE FOLLOWING CONTROL:

**CORNER MONUMENT** 

O WITNESS MONUMENT

(a)

FOR TIEG 5-1

BEAFINGS ARE BASED ON:

OBSERVATION SHEETS 33 \$7104

FIELD BOOK \_\_\_\_\_PAGE # \_\_\_\_ SHEET \_\_\_\_ OF \_\_\_\_ SHOW A PLAN VIEW DRAWING DEPICTING THE CORNER MONUMENT AND SURROUNDING

PHYSICAL FEATURES, INCLUDING THE EXCAVATION AREA AND DEPTH.
PLANNING & ZONING COMMITTEE ADOPTED THE ABOVE FORM ON 12/2/1982

corner code 6-1(1)

PL534

(B) Describe any record evidence, monument evidence, occupational evidence, testimonial evidence or any other material evidence you considered, and whether the monument was found or placed.

1833 MULLETT NORTH ON EAST SIDE OF SECTION 12 (T2N R10E)

528 LEAVE MARSH

1584 ENTER PRAIRIE

2640 SET QUARTER SECTION POST BUR OAK 8 N7W

211.86' NO OTHER

5280 SET POST CORNER SECTION 1&12 IN PRAIRIE MADE MOUND LAND ROLLING SECOND RATE DRY

PRAIRIE. BY GOOD OBSERVATION AT THIS

CORNER VAR 8-15E SEPT 8TH 1833

1843 STEBBIN TWP RD REC BK 1 PG 2 VARIATION OF NEEDLE 7 1/2 BEGINNING AT THE SE COR OF SEC 1 T2N R11E; THENCE WEST 2 1/2 MILES (THIS COURSE FROM QUARTER POST ON SOUTH SIDE OF SEC 1 TO SW COR SOUTH ON A RANGE FROM BELOIT TO MADISON) TO THE QUARTER STAKE ON THE SOUTH LINE OF SEC 3; THENCE N72W ONE MILE AND 20 CHAINS TO A STAKE; THENCE 59 WEST 1079.1' TO A BURR OAK TREE; THENCE N70W 815.1' TO A STAKE; THENCE S65W 2610.3' TO A BLACK OAK TREE; THENCE S45W 1894.2' TO SEC BETWEEN SECTIONS 5 & 8, 247.5' EAST OF THE SE COR OF SEC 6, T2N R11E; THENCE WEST FOUR MILES 3679.5' TO A STAKE ON THE SEC LINE BETWEEN SECS 4 & 9, 660' WEST OF THE QUARTER POST; THENCE N43 1/2W 838.2' TO A BURR DAK TREE; THENCE N65W 3444.54' TO A POINT ON THE LINE BETWEEN THE COUNTIES OF ROCK AND GREEN 341.88' SOUTH OF THE QUARTER POST ON THE WEST SIDE OF SEC 7, T2N, R10E AND THE WHOLE LENGTH OF THE ROAD IS 12 MILES 3927'

- 1858 CHURCH VOL 1 PG 66 STATE NOTHING ABOUT MON. 2690.16TO CEN OF SEC 7
- 1867 LOCKE VOL 1 PG 285 FD BTS BUT NOTES WRONG. SET STAKE (FROM CORNERS OF SEC) IN MOUND. OLD B TREE 9. O 8 N17W 214.5'. VAR 3-20 TO W 1/4 COR SEC 12 SPRING VALLEY, VAR 7-18 2657.82 TO NW COR SEC 7, & VAR 7-18 2657.82 TO SW COR SEC 7.
- 1868 LOCKE PG 80 SOUTH ON WEST LINE SEC 7 VAR 7-15
  - 2631.92 INTERSECTED 1/4 LINE AT COR. FOUND COR. AS SET BY SELF. (SEE CO. SURVEYORS RECORD SEC 7)
    COR 4.29' EAST OF SOD FENCE ON EAST SIDE OF HIGHWAY AND 31.68' NORTH OF FENCE RUNNING WEST GOVT BT IS N19-45W 217.8'
    - 5263.83 INTERSECTED SOUTH BOUNDARY AT COR. FOUND SOUTH B.T. STUMP OF NORTH B.T. AND COR AS SET BY SELF (SEE CO. S RECORD SEC 12 SPRING VALLEY) SEPT 15, 1868
- 1869 RUGER VOL 2 PG 9 STONE MON. SET BY LOCKE. 2682.9 TO CEN SEC 7 & 5344.02 TO E  $\frac{1}{4}$  COR SEC 7.
- 1979 BARNES VOL 5 PG 580 DUG & FD CUT L.S. 3' DEEP. SET ALUM. ON TOP OF STONE. 7' EAST OF EAST EDGE OF PVMT.
- 1979 BARNES VOL 6 PG 1 SB6-26-24E 5344.17 TO E 1/4 COR SEC 7, S5-36-08W 2630.13 TO SW COR SEC 7, & 20 +/- NORTH OF BRIDGE.
- 1988 BARNES G-1 FD ALUM. MON. DUG ALONG SIDE OF THE MON. & REPLACED SAME WITH POLY MON. POLY IS ON TOP OF CUT LIMESTONE. ALUM. MON. WILL BE TESTED TO ENSURE THAT VENDER'S CLAIMS ARE CORRECT. ACCEPTED FD PERPETUATED LOCATION. REFERENCED SAME. MON IS 7 EAST OF EAST PVMT EDGE.
- 1989 BARNES VOL 6 PG 402 FD POLY. N87-04-42E 2683.34 TO INT OF ½ LINES, N87-04-42E 5344.46 TO E ½ COR SEC 7, S0-52-50E 2630.15 TO SW COR SEC 7, & N0-47-20W 2630.45 TO NW COR SEC 7.

SHEET 1 OF 2 CORNER CODE G-1(1)

May 12 2003

PL534

1989 COMBS CSM VOL 14 PG 136 2630.42 TO NW COR SEC 7 AN ALUM. MON. FD ALUM. MON.

1993 COMBS MAP #10004 NORTH 2630.42' TO NW COR SEC 7 & SO-06-25E TO SW COR SEC 7.

## MONUMENT IS 7 EAST OF EAST PVMT EDGE.

C) Was the corner restored through acceptance of (1) an obliterated evidence location, or, (2) a found perpetuated location?

ACCEPTED POLY, MON THAT IS ON TOP OF CUT L.S. USED MY OLD OBSERVATIONS.

- D) Describe any material discrepancy between the location of the corner as restored or reestablished and the location of that corner as previously restored or reestablished by distance and direction. Show the discrepancy on the plan view drawing under (a), above. Show the distances between the corner as previously restored or reestablished and (1) the corner as restored or reestablished, and (2) to at least 4 of the witness monuments shown on the drawing in (a), above.
- (E) Was the corner reestablished through lost corner proportionate methods? If so, show the method, including the directions and distances to other public land survey corners used as evidence or used for proportioning the corner location.
- I, Donald Barnes, hereby certify that the corner location as identified by the corner code index was determined by me under my direction and control and that this U.S. Public Land Survey Monument Record is correct and complete to the best of my knowledge and belief.

Port Barres
May 12 2003
Emboss

SHEET 2 OF 2

CORNER CODE G-1(1)

A-E 7.08 REQUIREMENT