
## LAND SURVEY PUBLIC U.S. MONUMENT RECORD

For Public Land Survey Corners in:

WI ADMINISTRATIVE CODE A-E 7.08 REQUIREMENT

T. 2 N., R. 1/ E

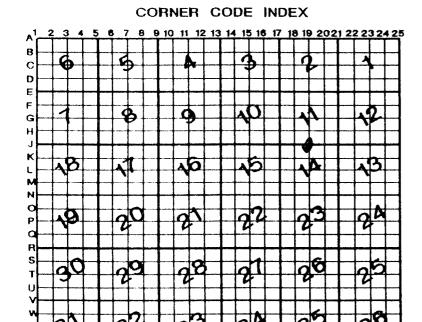

PLYMOUTH

ROCK COUNTY WI

IF AVAILABLE ROCK COUNTY COORDINATES PERFERRED

North Elev
East
Hor. Datum Vert. Datum
LATITUDEELLIPS. HT
LONGITUTE
GPS (X) TRAVERSE (X)
BASED ON THE FOLLOWING CONTROL:

**CORNER MONUMENT** 

PLACE MONUMENT SYMBOL & LOCATION ON ABOVE INDEX

O WITNESS MONUMENT

BEAFINGS ARE BASED ON:

(a)

ORSERVATION	Shee	325
-------------	------	-----

FIELD BOOK	PAGE #	SHEET
		NER MONUMENT AND SURROUNDING
·	INCLUDING THE EXCAVATION A IMITTEE ADOPTED THE ABOVE FORM	

PL550

(B) Describe any record evidence, monument evidence, occupational evidence, testimonial evidence or any other material evidence you considered, and whether the monument was found or placed.

1833 HARRISON EAST ON RAND BET 11 & 14

693 BROOK 13.2' 5.E.

1650 LEFT MARSH & ENTER TIMBER

2178 LEFT TIMBER & ENTER MARSH

2640 TEMPY 1/4 P

3168 LEFT MARSH & ENTER TIMBER

5302.44 INT. E BDY 36.96' N OF P LAND LEVEL & WET ZND RATE TIMBER BURR & RED O

CDR. WEST

2651.22 QUARTER SEC COR. {BURR O 26 583E 610.5' BURR O 26 BURR O 26}MARKED

5302.44 SEC COR

- 1855 CHURCH VOL 1 PG 34 & 35 STATES NOTHING ABOUT MON.

  VAR NB3 1/3E ALONG SOUTH LINE SEC 11. NB-20W 2640 TO

  CEN SEC 11 & NB-20W 5280 TO N 1/4 COR SEC 11.
- 1856 CHURCH VOL 1 PG 64 CALLS FOR 2673.99 TO CENTER OF SEC 14.
- 1865 LOCKE VOL 1 PG 240 CORNER LOST-SET STAKE AND SURROUNDED IT BY 3 LIMESTONES AND 1 SANDSTONE.
  CALLS FOR 2641.32 TO SE & SW CORNERS OF SEC 11 AND 2628.38 TO CENTER OF SEC 11.
- 1868 LOCKE REMON. FIELD NOTES

PG 40 WEST BETWEEN SECS 11 & 14 VAR 6-15

2640 SET TEMPORARY ¼ COR. COR. LOST

- 5307.39 INTERSECTED WEST BOUNDARY 40.26' NORTH OF COR. COR. LOST. SET IT IN BY "PROPORTIONAL DISTANCE" FROM CORS ONE MILE NORTH, EAST AND WEST AND ONE HALF MILE SOUTH. DROVE STAKES AT THE FACE OF THE MONUMENT AND SURROUND IT BY MOUND OF TUSSACKS.
- 2653.70 SET ¼ COR 13.70' AND 20.13' SOUTH OF TEMPORARY COR. COR. IN SOD FENCE RUNNING N & S VAR CORRECTED 6-41 AUG 28 1868
- 1869 LEE VOL 2 PG 2 STATES NOTHING ABOUT CORNER. CALLS FOR 2662.44 TO NE COR SEC 14 AND 2652.54 TO CENTER OF SEC 14.
- 1869 LEE VOL 2 PG 1 FOUND MON. CALLS FOR 2658.15 TO CENTER OF SEC 11 AND 2662.44 TO SE CORNER OF SEC 11.
- 1871 RUGER VOL 2 PG 67 FOUND STONE MONUMENT. CALLS FOR 2642.48 TO CENTER OF SEC 11 AND 364.24 TO STAKE DEEP WITH HH13X10X8 ON TOP NORTH OF CORNER.
- 1910 KERCH VOL 3 PG 61 FOUND MON. BADLY DISINTEGRATED. SET GAS PIPE. CALLS FOR 1330.2 TO S 1/16TH COR OF THE SE 1/4 OF SEC 11,1326.0 TO W 1/16TH COR OF THE SE 1/4,1326.5 TO W 1/16TH COR OF THE NE 1/4 OF SEC 14,416.55 TO CENTER OF R/R, ANGLE OF 89-25 AT S 1/4 COR SEC 11 FROM W 1/16TH COR OF SE 1/4 TO S 1/16TH COR OF SE 1/4 SEC 11, AND ANGLE OF 90-33-30 AT THE W 1/16TH COR OF SE 1/4 OF SEC 11 FROM CENTER OF SE 1/4 OF SEC 11.
- 191? KERCH MAP #4360 GAS PIPE. ANGLE OF 89-25 @ 5 ¼ COR SEC 11 FROM N/S ¼ LINE SEC 11 TO SOUTH LINE SEC 11. MON 355.1 NORTH OF NORTH R/R ROW & 416.54 NORTH OF GENTER OF R/R
- 1974 COMBS CSM VOL 4 PG 173 2575.05? TO CENTER OF SEC 14 A FD R/R SPIKE
- 1979 WIDOT "6" MAP #4341 & 13449 STATES NOTHING ABOUT MON.
- 1979 SCHNEEBERGER CSM VOL B PG 403 ¾" PIN 1982 BARNES VOL 6 PG 282 RFCOFD DISTANCES.
- 1992 SCROEDER CSM VOL 16 PG 108 STATES NOTHING ABOUT MON. 2652.98 TO CEN SEC 14.

DenaldBaines 1/14/03

SHEET 1 OF 2 CORNER CODE J-19(1)

## PL550

- 1995 BARNES J-19 FOUND 1/2" PIN SURROUNDED BY LARGE PIECES OF CUT LIMESTONE. GROUND WAS VERY WET. I WAS UNABLE TO SEARCH VERY DEEP BECAUSE OF THE WATER. I DID NOT FIND THE GAS PIPE THAT KERCH PLACED. I BELIEVE THE PIN IS INSIDE THE PIPE. PLACED CARSONITE POST ON WEST SIDE OF PIN. SHOWS RECORD DISTANCES. 1325.29' NORTH TO FD 2 ½" GAS PIPE @ EAST EDGE OF PVMT. & 5293.89 TO N ¼ COR SEC 11.36' NORTH OF SOUTH SIDE OF BARN (ABOUT 300') PROJECTED FROM THE WEST IN N/S FENCE.
- 1996 LATHROP MAP #9074 FD 3/4" PIN. 2655.71 TO NW COR SEC 14.
- 2000 COMBS CSM23-132 FD PIN 2652.36 TO CENTER OF SEC 14 A FD C.I.
- 2002 ERICKSON FED. NAD83 N89-09-30E 2659.52 TO NE COR SEC 14, 501-14-44E 2652.05 NAD83 TO CENTER OF SEC 14.

FD TIES & USED MY 1995 DBSERVATIONS.

C) Was the corner restored through acceptance of (1) an obliterated evidence location, or, (2) a found perpetuated location?

ACCEPTED PIN AS PERPETUATING CUT L.S.

- D) Describe any material discrepancy between the location of the corner as restored or reestablished and the location of that corner as previously restored or reestablished by distance and direction. Show the discrepancy on the plan view drawing under (a), above. Show the distances between the corner as previously restored or reestablished and (1) the corner as restored or reestablished, and (2) to at least 4 of the witness monuments shown on the drawing in (a), above.
- (E) Was the corner reestablished through lost corner proportionate methods? If so, show the method, including the directions and distances to other public land survey corners used as evidence or used for proportioning the corner location.
- I, Donald Barnes, hereby certify that the corner location as identified by the corner code index was determined by me under my direction and control and that this U.S. Public Land Survey Monument Record is correct and complete to the best of my knowledge and belief.

Seal

1/14/63

SHEET 2 OF 2

CORNER CODE J-19(1)

A-E 7.08 REQUIREMENT