Paper weight-110# (minimu-

Black nonfading ink require

PUBLIC

LAND


SURVEY MONUMENT RECORD

For Public Land Survey Corners

WI ADMINISTRATIVE CODE A-E 7.08 REQUIREMENT

T. 2 N. R. _//_E.

CODE INDEX **CORNER**

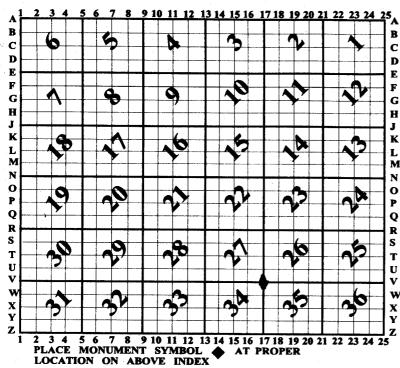

PLYMOUTH **TWP ROCK COUNTY WI**

IF AVAILABLE ROCK COUNTY COORDINATES PERFERRED

North	Elev.
East	
Hor. Datum	Vert. Datum
LATITUDE	ELLIPS. H
LONGITUDE _	
GPS (X)	TRAVERSE (X)
BASED ON THE	FOLLOWING CONTROL:

◆ CORNER MONUMENT

WITNESS MONUMENT \bigcirc

FO TIES

BEARINGS ARE BASED ON:

(a)

OBSERVATION 560075 179,180,190 FIELD BOOK PAGE # SHEET SHOW A PLAN VIEW DRAWING DEPICTING THE CORNER MONUMENT AND SURROUNDING PHYSICAL FEATURES, INCLUDING THE EXCAVATION AREA AND DEPTH. PLANNING & ZONING COMMITTEE ADOPTED THE ABOVE FORM ON 12/2/1982

CORNER CODE V-17(1)

PL609

(B) Describe any record evidence, monument evidence, occupational evidence, testimonial evidence or any other material evidence you considered, and whether the monument was found or placed.

1833 HARRISON

NORTH BET 34 & 35

2640 QUARTER SEC COR. BLK O 14 857W 33'; W.O. 13 N26W 33'; BLK O 14 & W.O. 13 MARKED

4835.16 BUR D 13

5280 COR TO SECS 26,27,34,&35 W.O. 14 S16W 38.94'; BUR OAK 1 S71E 132; BUR OAK 36 N78E 170.94'; BURR OAK 14 N70W 86.46'

EAST ON RAND BET. SECS 26 & 35

2640 TEMPY 1/4 POST

5308.38 INT. E BDG 32.34' S OF P. LAND ROLLING. 2ND RATE TIMBER W.O. BURR O HICK. ASPEN COR. WEST

2654.19 QUARTER SEC COR. {W.O. 24 N74E 158.4' W.O. 16 S85E 187.44' W.O. 24 W.O. 16} MARKED

4632.54 SEC COR

NORTH BET SECS 26 & 27

2640 QUARTER SEC COR (W.O. 36 S11E 59.4' W.O. 37 N22E 19.8' W.O. 36 WO 37) MARKED

3653.76 W.D. 36

5280 COR TO SECS 22 23 26 27 {W.O. 36 N59W 62.7' W.O. 16 N29E 75.9' W.O. 24 SB6E 247.5' W.O. 24 S57W 185.46' LAND ROLING 2ND RATE TIMBER W.O. & RED O ? ? & WEED

EAST ON RAND. BET 27 & 34

2640 TEMPY 1/4 P

5246.34 INT E. BDY 31.68' N OF P LAND ROLLING 1ST RATE WITH GOOD TIMBER W.O. & BLK O. ASPEN, LYNN, HICKY, WALNUT ASH CHERRY & ? OF P. ASH VINES

COR. WEST

2623.17 QUARTER SEC COR {W.O. 24 N5W 13.86' W.O. 16 SBBE 73.92' W.O 24 W.O. 16}

5246.34 INT W BDY AT P.

1844 PEASE TWP RD RECORDS BK 1 PG 4 COMMENCING AT THE CORNERS OF SEC 26,27,34 AND 35, IN T2N R11E AND RUNNING WEST ON THE LINE BETWEEN SECTIONS 27 & 34, 2622.84'. SET POST WHERE OLD 1/4 POST ON SAID LINE STOOD BURNT STUMP OF WHITE OAK BEARS N5W 13.86' AND 588E 73.92'; THENCE WEST ON SAID LINE 2622.84' TO THE CORNER OF SEC 27,28,33, & 34, SET POST WHITE OAK 24 INCHES IN DIA BEARS 635E 114.18', BURNT STUMP OF BASS WOOD 24" N78E 86.46"; THENCE WEST ON LINE BETWEEN SECS 28 AND 33 TO CORNER OF SEC 28,29,32 & 33 5224.5' SETING POST IN OLD MOUND; THENCE WEST ON LINE BETWEEN SECTIONS 29 & 32, 2652.8' SET POST BY BLACK DAK 24 INCH BEARS N26E 27.06'; THENCE WEST ON THE LINE BEFORE SAID 2642.64' TO THE COR OF SEC 29,30,31 & 32, BLACK DAK BEARS N41E 78? AND N22W 97.02'; THENCE WEST OF LINE BETWEEN SEC 30 & 31, 5297.16' TO THE LINE BETWEEN RANGES 10 & 11 EAST 4 MILES AND 5.94'. SAID RD EXTENDS 33' ON EACH SIDE OF THE ABOVE LINE.

1856 CHURCH VOL 1 PG 62 2665.08 TO N 1/4 COR SEC 35.

1868 LOCKE PG 10 WEST BETWEEN SEC 26 & 35 AUG 19 1868
2676.3 INTERSECTED 1/4 LINE AT COR. FOUND STUMPS OF
BTS AND STONE ON COR. COR IN CENTER OF
HIGHWAY CONTINUED WEST FROM 1/4 COR WITH

VAR 6-12

5349.96 INTERSECTED WEST BOUNDARY 15.84' NORTH OF COR. FOUND BT IN SEC 27 AND STUMPS OF BTS * IN 26 AND 34 AND STONE SET ON COR. BT IN 26 IS 137.94' AND BT IN 27 IS 156.42. COR IN CENTER OF HIGHWAY VAR CORRECTED 6-33 AUG 19 1868

Parld Baines 1/02/03

SHEET 1 OF 3 CORNER CODE V-17(1)

PL609 NORTH BETWEEN SECS 26 & 27 VAR 7-10 PG11 INTERSECTED 1/4 LINE 2.64' EAST OF COR. FOUND 2660.79 STUMPS OF NORTH B.T. AND STONE 0.66' NORTH OF COR. VAR CORRECTED 7-13 COR IN CENTER OF HIGHWAY CONTINUED NORTH WITH VAR 7-25 INTERSECTED NORTH BOUNDARY 4.29' WEST OF 5321.91 COR. VAR CORRECTED 7-19 AUG 19 1868 PG 13 EAST BETWEEN SECS 27 AND 34 VAR 6-18 INTERSECTED 1/4 LINE 21.12' NORTH OF COR. 2638.68 FOUND WHERE BTS WERE DUG OUT AND STAKE COR IN CENTER OF HIGHWAY AND IN LINE OF FENCE FUNNING NORTH VAR CORRECTED 5-50 CONTINUED EAST WITH VAR 5-20 INTERSECTED EAST BOUNDARY 23.43' SOUTH OF 5288.25 COR. VAR CORRECTED 5-50 BOUTH BETWEEN BECS 34 & 35 VAR 6-55 PG 14 INTERSECTED 1/4 LINE AT COR. FOUND NORTH BT 2650.56 AND STUMP OF SOUTH BT AND OLD STAKE COR IN CENTER OF HIGHWAY CONTINUED SOUTH FROM 1/4 COR WITH VAR 6-30 SET OFF 15.51' EAST 4092 SET OFF 9.9' EAST 4290 SET OFF 12.21' WEST 4488 SET OFF 14.52' EAST 4752 SET OFF 16.5' EAST 5016 SET OFF 19.8' WEST 514B 5307.72 INTERSECTED SOUTH BOUNDARY 5.28' WEST OF COR FOUND EAST BT AND STUMP OF WEST BT AND OLD STAKE VAR CORRECTED 7-08 1/2 AUG 20 1868 1869 LEE VOL 1 PG 338 FD MON. VAR 5-54 2673.00 TO S 1/4 COR SEC 26 VAR 6-55 2663.10 TO W 1/4 COR SEC 26. 1873 RUGER VOL 2 PG 114 STONE MON. VAR 6-20 2651.94 TO E 1/4 COR SEC 34 & VAR 5-15 2643.30 TO N 1/4 COR SEC 34. 1874 RUGER VOL 2 PG 122 STONE MON. 1876 RUGER VOL 2 PG 206 STONE MON. 1965 BATTERMAN VOL 4 PG 222 FD CUT STONE MON. REF. SAME. ALSO PAGE 261 FOR NEW TIES. 1965 WIDOT PROJECT S11-01(1) STATES NOTHING ABOUT MON. 1966 BATTERMAN VOL 4 PG 261 MON BOX. NEW TIES. 1966 COMBS CEMETERY PLATS VOL 1 PG 62 3" ROUND ALUM 2660.16 TO E 1/4 COR SEC 27 1966 BATTERMAN VOL 4 PG 283 MON BOX NEW TIES. WIDOT DISK IN CONC. AS REF. MARKS. N89-47W TO N 1/4 COR SEC 34 & N89-40E TO 5 1/4 COR SEC 26. 1967 BATTERMAN VOL 4 PG 326 CHAINED 2673.06 TO 5 1/4 COR SEC 26. 1971 THOM CSM 2-164 FD MON. CHECK PAPER COPY 1982 COMBS CSM VOL 11 PG 271 ALUM. 2660.16 TO E $^{1\!\!4}$ COR SEC 27 1983 LEUENBERGER MAP #04348 FD PIPE IN MON. BOX 1987 COMBS CSM13-97 MON BOX 1983 COMBS CSM VOL 11 PG 399 FD MON. 1991 BARNES V-17 FD 1" PIPE IN MON. BOX @ INTERSECTION OF CENTER OF PVMT. REFERENCED SAME. ROAD PAVING PROJECT WILL INVOLVE THIS CORNER. DID NOT ACCEPT NOR REJECT MON. REFERENCED FD MON SO IT WOULD NOT BE DESTROYED BY THE PAVING PROJECT. 1996 SCHROEDER CSM VOL 19 PG 12 STATES NOTHING ABOUT MON. 1996 COMBS CEMETERY PLATS VOL 1 PG 62 "3" ADDITION TO HANDVER CEMETERY" FD 3" RD ALUM. 2660.16 TO E 1/4 COR **SEC 27** 1997 SCHROEDER MAP #08593 STATES NOTHING ABOUT MON. 1999 HOULE CSM VOL 22 PG 331 PIPE IN MON BOX 2654.17 TO H.H. 2' DEEP @ E 1/4 COR SEC 34. SHEET 2 OF 3 CORNER CODE V-17(1)

Omald Barnes 1/02/03

2000 KREBS CSM VOL 23 PG 283 FD PIPE IN MON. BOX 2673.28 TO N 14 COR SEC 35

FOUND 1" PIPE IN MON. BOX & REFERENCE TIES. PIPE IS 0.7' BELOW MON. TOP; 1' SOUTH OF E/W CENTER PVMT.; & ON LINE WITH CENTERLINE OF N/S PVMT.

C) Was the corner restored through acceptance of (1) an obliterated evidence location, or, (2) a found perpetuated location?

ACCEPTED FD 1" PIPE IN MON BOX, WHICH PERPETUATED OUT L.S.

- D) Describe any material discrepancy between the location of the corner as restored or reestablished and the location of that corner as previously restored or reestablished by distance and direction. Show the discrepancy on the plan view drawing under (a), above. Show the distances between the corner as previously restored or reestablished and (1) the corner as restored or reestablished, and (2) to at least 4 of the witness monuments shown on the drawing in (a), above.
- (E) Was the corner reestablished through lost corner proportionate methods? If so, show the method, including the directions and distances to other public land survey corners used as evidence or used for proportioning the corner location.

I, Donald Barnes, hereby certify that the corner location as identified by the corner code index was determined by me under my direction and control and that this U.S. Public Land Survey Monument Record is correct and complete to the best of my knowledge and belief.

SHEET 3 OF 3

Purlo Erenes Emioss 1/02/03

V-17(1) CORNER CODE

A-E 7.08 REQUIREMENT