U.S.


## PUBLIC LAND SURVEY MONUMENT RECORD

For Public Land Survey Corners in:

WI ADMINISTRATIVE CODE A-E 7.08 REQUIREMENT

T. ZN., R. //E

CORNER CODE INDEX

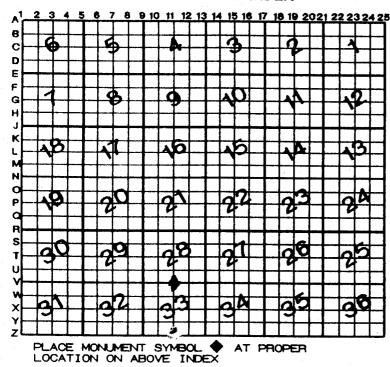

PLYMOUTH TWE

IF AVAILABLE
ROCK COUNTY COORDINATES PERFERRED

North \_\_\_\_\_\_ Elev. \_\_\_\_\_

East \_\_\_\_\_\_

Hor. Datum \_\_\_\_\_ Vert. Datum \_\_\_\_\_

LATITUDE \_\_\_\_\_ ELLIPS. HT.

LONGITUTE \_\_\_\_\_ TRAVERSE (X) \_\_\_\_

BASED ON THE FOLLOWING CONTROL:

**♦**CORNER MONUMENT

O WITNESS MONUMENT

Ż

(a)

0
Ω
ш
SED
⋖
m
ш
$\overline{\mathbf{c}}$
ARE
•
ഗ
INGS
¥
=
Œ
⋖
SEAFIL
m

OBSERVATION	SHEE	=5 A	-154	41	6

FIELD BOOK \_\_\_\_PAGE # \_\_\_\_ SHEET \_\_\_ OF \_\_\_ SHOW A PLAN VIEW DRAWING DEPICTING THE CORNER MONUMENT AND SURROUNDING

PHYSICAL FEATURES, INCLUDING THE EXCAVATION AREA AND DEPTH.
PLANNING & ZONING COMMITTEE ADOPTED THE ABOVE FORM ON 12/2/1982

CORNER CODE V-1/(3)

## PL606

(B) Describe any record evidence, monument evidence, occupational evidence, testimonial evidence or any other material evidence you considered, and whether the monument was found or placed.

1833 HARRISON EAST ON RAND. BET 28 & 33

2640

TEMPY 1/4 P

3993

LEFT PRAIRIE & ENTER TIM

5296.5

INT. E. BDY 18.48' N OF P LAND FOR 1  $^{\rm ST}$   $^{\rm 3}\!\!/_4$  SAME AS BEFORE LAST  $^{\rm 1}\!\!/_4$  ROLLING  $^{\rm ND}$  RATE WITH BURR & W.O. TIMBER

COR. WEST

2648.25 QUARTER SEC COR. {SET POST & RAISED MOUND 5296.5 INT. SEC COR

- 1844 PEASE TWP RD RECORDS BK 1 PG 4 COMMENCING AT THE CORNERS OF SEC 26,27,34 AND 35, IN T2N R11E AND RUNNING WEST ON THE LINE BETWEEN SECTIONS 27 & 34, 2622.84'. SET POST WHERE OLD 1/4 POST ON SAID LINE STOOD BURNT STUMP OF WHITE OAK BEARS N5W 13.86' AND SBBE 73.92'; THENCE WEST ON SAID LINE 2622.84' TO THE CORNER OF SEC 27,28,33, & 34, SET POST WHITE OAK 24 INCHES IN DIA BEARS 535E 114.18', BURNT STUMP OF BASS WOOD 24" N78E 86.46'; THENCE WEST ON LINE BETWEEN SECS 28 AND 33 TO CORNER OF SEC 28,29,32 & 33 5224.5' SETTING POST IN OLD MOUND; THENCE WEST ON LINE BETWEEN SECTIONS 29 & 32, 2652.8' SET POST BY BLACK OAK 24 INCH BEARS N26E 27.06'; THENCE WEST ON THE LINE BEFORE SAID 2642.64' TO THE COR OF SEC 29,30,31 & 32, BLACK DAK BEARS N41E 78? AND N22W 97.02'; THENCE WEST OF LINE BETWEEN SEC 30 & 31, 5297.16' TO THE LINE BETWEEN RANGES 10 & 11 EAST 4 MILES AND 5.94'. SAID RD EXTENDS 33' ON EACH SIDE OF THE ABOVE LINE.
- 1855 CHURCH VOL 1 PG 38 STONE 20" LONG 5" THICK. S35 3/4E 170.12 TO NW COR OF SMITZS HOUSE, N28 1/2W 29.37 TO 6" LOCUST TREE, VAR 6 2664.75 TO NW COR SEC 33, & VAR 6 2664.75 TO NE COR SEC 33.
- 1868 LOCKE PG 18 WEST BETWEEN SECS 28 & 33 VAR 6

143.22 BROOK BRIDGE 6.6' WIDE

- 2671.02 INTERSECTED 1/4 LINE AT STONE SET BY CHURCH CENTER OF ROAD. (SEE CO. SURVEYORS RECORD SEC 28). CONTINUED WEST WITH VAR 6-10 54.10 CENTER SLUICE BRIDGE 3.3' WIDE.
- 5342.04 INTERSECTED WEST BOUNDARY AT STONE SET BY CHURCH. (SEE CO. SURVEYORS RECORD) JAKE FISHER, T IMYLIE AND SEVERAL OTHER NEIGHBORS UNITE IN DECLARING THAT THE OLD CORNERS IN SEC 28 HAD BEEN KEPT UP & THAT THESE STONES SET BY CHURCH WERE SET WHERE THE OLD CORNERS WERE. COR 34 22.77' SOUTH AND 1.32' EAST OF CORNER OF J. FISHERS FENCES IN NORTH & WEST SIDES OF HIGHWAYS.
- 1871 RUGER VOL 1 PG 38 & 75 STONE MON. 2667.22 TO NW COR SEC 33, 2664.75 TO NE COR SEC 33, 2661.12 TO CENTER OF SEC 33, & 5321.78 TO S 1/4 COR SEC 33. VAR OF 5-33 ON NORTH LINE OF NW 1/4 AND VAR OF 5-15 ON NORTH LINE OF NE 1/4 OF SECTION 33.
- 1978 BARNES VOL 5 PG 473 CALLS FOR N88-56-51W 2670.13 TO NW COR SEC 33 SD-02-09W 2666.3 TO FENCE POST NEAR CENTER OF SEC 33, SO-02-09W 5331.90 TO S1/4 COR SEC 33, & S88-43-18E 2670.13 TO NE COR SEC 33.
- 1979 BARNES VOL 6 PG 125 SET ALUM. MON AT SINGLE
  PROPORTIONATE MEASUREMENT FROM THE NE & NW CORNER
  OF SEC 33. USED RUGER'S PRORATED DISTANCE FROM THE
  CENTER OF THE SECTION 33 TO CONTROL THE N/S POSITION.
  LOCKE'S REMONUMENTATION NOTES STATES THE CORNER IS
  NOT ON A STRAIGHT LINE BETWEEN THE NE & NW CORNERS

SHEET 1 OF 2 CORNER CODE V-11(3)

DenoldBarres

PL606

OF SEC 33. THE TERRAIN INDICATES A LARGE ROAD CUT. DUG 36" DEEP AND FOUND SAND BUT NOT THE OLD ROAD BED AS FOUND AT THE NW & NE CORNERS. SAND WAS FOUND UNDER THE OLD ROAD AT THOSE CORNERS. IF PLACED ON A STRAIGHT LINE THE CORNER WOULD BE FURTHER SOUTH BY 5 FEET. IF SET AT THE CENTERLINE OF THE EXISTING ROAD, THE DIFFERENCE IN BEARING BETWEEN THE NW & NE CORNER WOULD BE 0-05-28. THE RECORD DIFFERENCE IN BEARINGS ARE:

RUGER (1871) O-18, LOCKE (1868) O-10, AS SET O-12-33, & IF AT CENTER OF PVMT O-05-28

1979 BARNES VOL 6 PG 137 SET ALUM. MON AT PROPORTIONATE MEASUREMENT FROM THE NE & NW CORNERS OF SEC 33.

USED RUGER'S PRORATED DISTANCES FROM THE CENTER OF THE SECTION {33} TO CONTROL THE N/S POSITION. LOCKE'S REMONUMENTATION NOTES STATES THE COR WAS IN THE CENTER OF THE OLD RD AND THE VAR INDICATES THE COR IS NOT ON A STRAIGHT LINE BETWEEN THE NE & NW CORNERS OF SEC 333. THE TERRAIN INDICATES A LARGE RD CUT.

DUG 36" DEEP AND FD SAND BUT NOT THE OLD RD BED AS FOUND AT THE NW & NE CORNERS OF SEC 33. IF PLACED ON A STRAIGHT LINE THE COR WOULD BE FURTHER SOUTH BY 5'. IF SET AT THE CENTERLINE THE DIFFERENCE IN THE BEARING BETWEEN THE NW AND THE NE CORNER IS 0-05-28. THE RECORD DIFFERENCE IN BEARINGS ARE:

RUGER (1871) 0-18 LOCKE (1868) 0-10 AS SET 0-12-33

IF AT CENTER OF RD 0-05-28

DRAWING SHOWS 71 NORTH OF CENTERLINE OF STH 213
1980 COMBS MAP #04417 FD ALUM. SOUTH TO E 1/4 COR SEC 33
& N88-46-15W TO N 1/4 COR SEC 33.

1981 COMBS CSM VOL 10 PG 285 ALUM

1984 BARNES V-11 WIDOT ALUM. REF SAME STA 515+30 7' RT 1984 BARNES DOT Z-11 & Z-11(1) REFERENCED CORNER WITH #5 REBAR.

1992 COMBS CSM16-157 PK 2670.10 TO PK @ SW COR SEC 28 1992 COMBS CSM16-160 SET PK 2670.32 TO SET PK @ NE COR SEC 33

1992 COMBS CSM VOL 16 PG 162 2670.32 TO NE COR SEC 33 SET PK FROM COUNTY SURVEYOR REC.

1998 BARNES V-11(2) FOUND DOT REBARS. FOUND PK AND 1.6'
DEEP FOUND BOTTOM HALF OF ALUM. MON. PLACED 3
MAGNETS ON TOP. FD PK 874-02-20W 0.03' OF ALUM. MON.
MON IS 7' NORTH OF CENTER LINE OF E/W PVMT.
REFERENCED SAME.

I FOUND THE REFERENCE TIES & I USED MY 1998 OLD OBSERVATIONS.

C) Was the corner restored through acceptance of (1) an obliterated evidence location, or, (2) a found perpetuated location?

ACCEPTED FD BOTTOM HALF OF ALUM. MON. AS PERPETUATED BY TIES.

I, Donald Barnes, hereby certify that the corner location as identified by the corner code index was determined by me under my direction and control and that this U.S. Public Land Survey Monument Record is correct and complete to the best of my knowledge and belief.

SHEET 2 OF 2

Porto Baines Emilias 15/03