U.S.


## PUBLIC LAND SURVEY MONUMENT RECORD

For Public Land Survey Corners in:

WI ADMINISTRATIVE CODE A-E 7.08 REQUIREMENT

T. 2N., R. //E

CORNER CODE INDEX

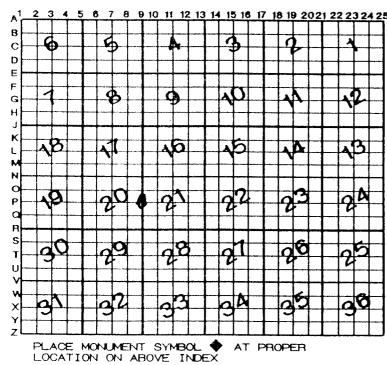

PLYN	OUTH	TW1
	COUNTY	

IF AVAILABLE ROCK COUNTY COORDINATES PERFERRED

North	Elev
East	
Hor. Datum	Vert. Datum
LATITUDE _	ELLIPS. HT
LONGITUTE	Market de la companya del companya del companya de la companya de
GPS (X)	TRAVERSE (X)
BASED ON THE	FOLLOWING CONTROL:

**♦** CORNER MONUMENT

WITNESS MONUMENT

BEAFINGS ARE BASED ON:

(a)

OBSERVATION SHEET 2964 576

FIELD	воок	PAGE #		SHEET L OF Z
SHOW	A PLAN VIEW	DRAWING DEPICTING	THE CORNER MONUMENT	AND SURROUNDING
PHYSIC	AL FEATURES	INCLLIDING THE EVOX	WATION ADEA AND DEDT	<b>J</b>

PLANNING & ZONING COMMITTEE ADOPTED THE ABOVE FORM ON 12/2/1982

corner code  $\cancel{P9}(1)$ 

PL565

(B) Describe any record evidence, monument evidence, occupational evidence, testimonial evidence or any other material evidence you considered, and whether the monument was found or placed.

1833 HARRISON

NORTH BETWEEN SECS 20 & 21

1716 LEFT PRAIRIE & ENTER TIMBER

2265.78 RED 0 12

2640 QUARTER SEC COR. {BURR D 24 N49E 26.4' BUR D. 6 N78W 9.24' BURR D 24 BURR D 6} MARKED

3333 LEFT TIMBER & ENTER MARSH

5280 COR TO SECS 16 17 20 21 IN MARSH  $\{BURR O 24 S79W 24B.B2' BURR O 10 N62W 271.26' LEVEL 1^{ST} 
$^{1}/_{4} ROLLING 1^{ST} RATE PRAIRIE - REMAINDER ROLLING 
$^{ND} RATE WITH BUR & WO TIMBER$$ 

EAST ON RAND. BET 16 & 21

2640 SET TEMPY 1/4 P

2838 LEFT MARSH & INTO TIMBER

3300 LEFT TIM. & ENTER MARSH

4422 LEFT MARSH & ENTER TIMBER

5265.48 INT. E BDY 17.82' N  $\Box$ F P LAND LEVEL & WET  $\mathbf{Z}^{\text{ND}}$  RATE TIMBER BURR 7 BLK  $\Box$ 

COR. WEST

672.54 BURR 0 24

1971.42 BURR 0 16

2632.74 QUARTER SEC COR BURR O 12 S81E 264' BURR O 12 N38E 227.04'

NORTH BET 16 & 17

2640 QUARTER SEC COR IN MARSH POST & RAISED MOUND

4158 BROOK 6.6' CRS S.E.

4587 LEFT MARSH & ENTER TIM.

5280 COR TO SECS 8, 9,16,17 {W.O. 24 N39E 128.04' W.O. 36 N19W 118.80' BURR D 24 S71W 235.62' BURR D 18 S5E 100.32' LAND MOSTLY LEVEL & WET 3<sup>RD</sup> RATE MARSH.

EAST ON RAND BET 17 & 20

1650 BROOK 3.3' CRS N.W.

2310 ENTER TIM & LEAVE MARSH

2640 TEMPY 1/4 P

514B LEFT TIM & ENTER MARSH

5311.68 INT. E BDY 26.4' S  $\Box$ F P. LAND LEVEL & WET  $\exists^{RD}$  RATE MOSTLY MARSH – TIM BURR  $\Box$ .

COR. WEST

2655.84 QUARTER SEC COR. {BURR 0 16 S86W 58.74' BURR 0 19 S61W 47.52' BURR 0 16 BURR 0 29}
MARKED

5311.68 SEC COR

1868 LOCKE PG 59 COMMENCED AT COR FOR SECS 15,16,21 & 22 AND RUN WEST BETWEEN SECS 16 & 21 VAR 5-55

2651.22 INTERSECTED 1/4 LINE 1.32' SOUTH OF COR. FOUND STUMPS OF BTS. DISTANCE TO SOUTH BT 297' COR 1.32' NORTH AND 1.32' EAST OF FENCE COR. VAR CORRECTED 5-53

CONTINUED WEST FROM 1/4 COR WITH VAR 5-30

3977.16 FENCE RUNNING N AND S

5301.78 INTERSECTED WEST BOUNDARY 17.82' NORTH OF COR. FOUND BTS SOUTH BT IS SOUTH 82 W 237.6' COR IS 6 INCHES NORTH OF CENTER OF COR POST TO FENCE VAR CORRECTED 5-53 SEPT 9 1868 PG 67 EAST BETWEEN SECS 17 AND 20 VAR 7

O SET OFF 52.14' SOUTH

2677.95 INTERSECTED 1/4 LINE 6.27' NORTH OF COR. FOUND SOUTH BT AND STUMP OF WEST B.T. AND STAKE.

COR. IN LINE OF N AND S FENCE AND 2.31' SOUTH OF E & W FENCE VAR CORRECTED 5-45

SHEET 1 OF 2 CORNER CODE P-9(1)

Dund Banes

1-03-03

## PL565

CONTINUED EAST FROM 1/4 COR WITH VAR 6-25

2677.95 SET OFF 3.3' NORTH

3828 SET OFF 6.27' SOUTH

SET OFF 4.95' SOUTH 4224

SET OFF 14.52' SOUTH 4422

5347.98 INTERSECTED EAST BOUNDARY 4.29' SOUTH OF COR. VAR CORRECTED 6-02 SEPT 10 1868 PG 84 NORTH BETWEEN SECS 16 & 17 VAR 7-32

2457.18 CENTER OF RR TRACK

SET TEMPORARY 1/4 COR COR LOST.

CENTER OF BROOK 7.92' WIDE 3488.1

CENTER OF BROOK 7.92' WIDE 3656.4

5311.02 INTERSECTED NORTH BOUNDARY AT COR.

2655.51 SET 1/4 COR 15.51' NORTH OF TEMPORARY 1/4 COR SURROUNDED MONUMENT WITH STAKES AND SEPT 16, 1868 MOUND

PG 60 SOUTH BETWEEN SECS 20 AND 21 VAR 6-15

1980 LEFT MARSH & ENTER TIMBER

2655.51 INTERSECTED 1/4 LINE 31.68' WEST OF COR. FOUND STUMP OF EAST BT AND WHERE WEST BT WAS ROTTED OUT AND COR. AS SET BY SELF (SEE CO. SURVEYOR RECORD SEC 20) COR. IN CENTER OF HIGHWAY. VAR CORRECTED 6-56

CONTINUED SOUTH FROM 1/4 COR WITH VAR 7

5315.31 INTERSECTED SOUTH BOUNDARY 27.06' WEST OF COR. VAR CORRECTED 7-35 SEPT 9 1868

1869 LEE VOL 1 PG 357 VAR 7-50 2656.50 TO W 1/4 COR SEC 21, 2672.34 TO N 1/4 COR SEC 20, & FD MON.

1974 LEE VOL 5 PG 9 FD CUT STONE BROKEN. SET 1" PIPE 3' DEEP & REFERENCED SAME.

1978 BARNES VOL 5 PG 430 FD ALUM. MON. 2651 TO CENTER OF EXCAVATION AT E 1/4 COR SEC 20

1978 BARNES VOL 5 PG 489 2655.29 TO W 1/4 COR SEC 21 AND ANGLE OF 179-18-44 @ W  $^{1/4}$  COR SEC 21 FROM NW COR SEC 21 TO SW COR SEC 21.

1994 LATHROP CSM18-47 ALUM. 2656.16 TO ALUM @ E 1/4 COR SEC 20

1995 LATHROP MAP #9364 FD ALUM. 2656.16 TO E 1/4 COR SEC 20

1995 LATHROP MAP #9288 FD ALUM. SOUTH 1328.19 TO  $1/16^{TH}$ COR & N89-12-50W ALONG NORTH LINE OF SEC 20.

1996 KREBS MAP #8908 FD ALUM. MON. 2652.61 TO N 1/4 COR SEC 21.

2000 KREBS MAP #7598 & 7599 FD ALUM N88-48-19W 2669.08 TO S 1/4 COR SEC 17, NO-06-21W 2657.49 TO E 1/4 COR SEC 17, & SD-24-24W 2656.16 TO E 1/4 COR SEC 20.

2001 LEUENBERGER MAP #14141 STATES NOTHING ABOUT MON.

## FD ALUM. MON & REFERENCE PIPES

C) Was the corner restored through acceptance of (1) an obliterated evidence location, or, (2) a found perpetuated location?

ACCEPTED FD ALUM. MON., WHICH PERPETUATES THE CUT L.S.

I, **Donald Barnes**, hereby certify that the corner location as identified by the corner code index was determined by me under my direction and control and that this U.S. Public Land Survey Monument Record is correct and complete to the best of my knowledge and belief.

Dureld Barres 7-03-04

SHEET 2 OF 2

CORNER CODE P-9 (1)