Paper weight \_\_\_\_\_inimum)

Black nor required


## U.S. PUBLIC LAND SURVEY MONUMENT RECORD

For Public Land Survey Corners in:

WI ADMINISTRATIVE CODE A-E 7.08 REQUIREMENT

T. 2N., R. 18 E

CORNER CODE INDEX

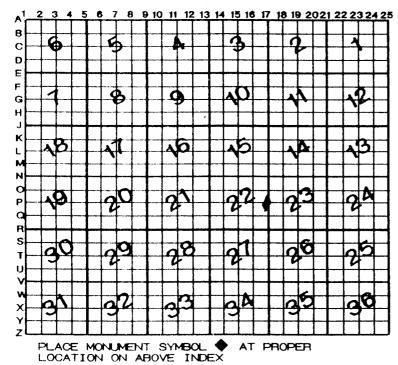

PLYMOUTH TWP ROCK COUNTY WI

IF AVAILABLE ROCK COUNTY COORDINATES PERFERRED

North Elev
Park.
East
Hor. Datum Vert. Datum
LATITUDE ELLIPS. H
LONGITUTE
GPS (X) TRAVERSE (X)
BASED ON THE FOLLOWING CONTROL:

**♦**CORNER MONUMENT

O WITNESS MONUMENT

BEAFINGS ARE BASED ON:

(a)

(	OBSERVAT	100	ShEETS	7/, 139, 35	795	78		
FIELD	BOOKP	AGE #_			SHEET		OF	2

SHOW A PLAN VIEW DRAWING DEPICTING THE CORNER MONUMENT AND SURROUNDING PHYSICAL FEATURES, INCLUDING THE EXCAVATION AREA AND DEPTH.
PLANNING & ZONING COMMITTEE ADOPTED THE ABOVE FORM ON 12/2/1982

## PL578

(B) Describe any record evidence, monument evidence, occupational evidence, testimonial evidence or any other material evidence you considered, and whether the monument was found or placed.

1833 HARRISON NORTH BET. 22 & 23

2278.98 W.D. 18

QUARTER SEC COR. (W.O. 24 N75W 33' BLK O 10 525E 32.34' W.O. 24 BLK O 10} MARKED

3666.96 W.C. 18

5280 COR TO SECS 14 15 22 23 (BURR O 18 S29E 70.62' BURR 0 14 S4W 79.2' BURR 0 6 N79W 91.74' BLK 🛭 11 N73E 186.78' LAND ROLLING 2ND RATE WITH TIMBER & BURR O BLK D. HICKY, W.O. BUSHES, GRASS & WEEDS

- 1848 TWP RD REC BK 1 PG 23 & 24 BEGINNING AT THE  $^{\prime\prime}$  POST ON THE NORTH LINE OF SEC OF 11 OF T2, R11E OF THE  $\mathbf{4}^{\mathsf{TH}}$ P.M. AND RUNNING THENCE SOUTH 3960' ON THE LINE THROUGH THE CENTER OF SEC; THENCE RUNNING S17-30W 1996.5' TO THE CENTER OF NEW BRIDGE OVER BASS CREEK AND RUNNING THENCE 532-30W 1122' TO THE RD THROUGH THE CENTER OF THE W ½ OF SEC 14, SAME TWP AND RANGE. MAGNETIC VARIATION 6-30 EAST; THENCE SOUTH ON THE HALF QUARTER LINE TO THE SOUTH LINE OF SEC 14; THENCE WEST 1320' ON THE SEC LINE TO THE NW COR OF SEC 23; THENCE SOUTH ON THE SEC LINE BETWEEN COR OF SEC 23; THENCE SOUTH ON THE SOUTH LINE BETWEEN SECS 22 & 23 AND 26 AND 27,34, & 35 TO THE SOUTH LINE OF THE TOWN. SAID RD IS 66' IN WIDTH.
- 1868 LOCKE PG 23 NORTH BETWEEN SECS 22 & 23 VAR 7-12 2364.12 W D. LINE TREE
  - 2650.56 INTERSECTED 1/4 LINE 6.6' WEST OF COR. FOUND WEST BT AND OLD STAKE VAR CORRECTED 7-04 SET OFF 15.18' EAST FROM 1/4 COR AND AND CONTINUED NORTH WITH VAR 7-28
  - 5305.DB INTERSECTED NORTH BOUNDARY 5.94' WEST OF COR. VAR CORRECTED 7 AUG 24, 1868
- 1870 RUGER VOL 2 PG 47 FD STONE MON. BY LOCKE. VAR6-24 2655.18 TO CENTER SEC 23, VAR 6-24 5320.26 TO E  $\frac{1}{4}$ COR SEC 23, VAR 6-32 2646.93 TO SW COR SEC 23, & VAR 6-56 2649.90 TO NW COR SEC 23.
- 1969 BATTERMAN VOL 4 PG 403 DUG & FD CUT L.S. 1.5' DEEP. REFERENCED SAME.
- 1979 BARNES VOL 6 PG 11 FD 1" PIPE AT E  $^{\prime\prime}$  COR SEC 22, SO-15-36W 1324.90 TO FD PK & TIES. SET 3/4X32 BOLT AT PK, FROM PK TO SE COR SEC 22 SO-23-56W 1323.19.
- 1979 BARNES VOL 6 PG 280 SO-15-36W TO 1/16 $^{ extstyle{TH}}$  COR WHICH IS WEST 1.70 OF A LINE BETWEEN THE E 1/4 COR SEC 22 & THE SE COR SEC 22, NO-06-46E FROM SE COR SEC 22 TO  $1/16^{\text{TH}}$ COR.
- 1980 BARNES FD 1X6" PIPE. REMOVED PIPE & SET 12" ALUM. MON. ON TOP OF CUT L.S. NO-09-34E 2654.11 TO NE COR SEC 22, NE COR SEC 22 TO N  $\frac{1}{4}$  COR SEC 22 NBB-35-40W 2632.72, NE COR SEC 22 S89-31-57E 1333.14 TO 1/16 COR.
- 1980 BARNES VOL 6 PG 40 FD 1X6" I.P. REMOVED & SET 12" ALUM ON TOP OF CUT L.S. 2654.11 TO NE COR SEC 22.
- 1980 TALARCYZK CSM VOL 10 PG 3 FD ALUM NORTH TO NE COR SEC 22 & N88-42-07W TO N  $^{\prime\prime}$  COR SEC 22.
- 1982 BARNES VOL 6 PG 282. N89-47-3E 2658.28 TO FD STONE AT CENTER SEC 23, NB9-43-50E 2666.79 FROM CENTER TO E  $V_4$  COR SEC 23, E  $V_4$  COR 22 TO SE COR SEC 22 NO-34-16E 2647.77, E  $rac{1}{4}$  COR SEC 22 TO NE COR SEC 22 NO-42-52W

Divid Bassel SHEET 1 OF 2 CORNER CODE P-17(1)

PI 578

1983 COMBS CSM VOL 11 PG 216 FD ALUM.

1991 BARNES P-17 FD ALUM. MON. @ CENTER OF N/S PVMT & WEST REFERENCE PIPE. REFERENCED COR. ROAD PAVING PROJECT WILL INVOLVE THIS CORNER. DID NOT ACCEPT NOR REJECT MON.

1998 SCHROEDER CSM VOL 22 PG 38 STATES NOTHING ABOUT MON. 2001 COMBS CSM VOL 24 PG 360 FD ALUM. 2658.35 TO CEN SEC 23

FD ALUM, MON, WITH TOP BROKE OFF & REFERENCE MONUMENTS. MONUMENT IS DISSOLVING BADLY

C) Was the corner restored through acceptance of (1) an obliterated evidence location, or, (2) a found perpetuated location?

ACCEPTED FD ALUM. MON, WHICH PERPETUATES THE CUT L.S.

- D) Describe any material discrepancy between the location of the corner as restored or reestablished and the location of that corner as previously restored or reestablished by distance and direction. Show the discrepancy on the plan view drawing under (a), above. Show the distances between the corner as previously restored or reestablished and (1) the corner as restored or reestablished, and (2) to at least 4 of the witness monuments shown on the drawing in (a), above.
- (E) Was the corner reestablished through lost corner proportionate methods? If so, show the method, including the directions and distances to other public land survey corners used as evidence or used for proportioning the corner location.
- I, Donald Barnes, hereby certify that the corner location as identified by the corner code index was determined by me under my direction and control and that this U.S. Public Land Survey Monument Record is correct and complete to the best of my knowledge and belief.

SHEET 2 OF 2

Donald Baines
Emboss
1/06/03

GORNER GODE P-17(1)

A-E 7.08 REQUIREMENT