U.S.


PUBLIC LAND SURVEY MONUMENT RECORD

For Public Land Survey Corners in:

WI ADMINISTRATIVE CODE A-E 7.08 REQUIREMENT

T. 2N., R. 1/E

CORNER CODE INDEX

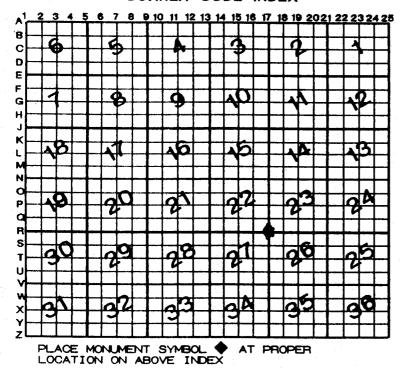

PLYMOUTH TWP ROCK COUNTY WI

IF AVAILABLE
ROCK COUNTY COORDINATES PERFERRED

North ______ Elev. _____

East _____

Hor. Datum _____ Vert. Datum _____

LATITUDE _____ ELLIPS. HT.

LONGITUTE _____ ERLIPS. HT.

GPS (X) ____ TRAVERSE (X) ___

BASED ON THE FOLLOWING CONTROL:

◆ CORNER MONUMENT

O WITNESS MONUMENT

BEAFINGS ARE BASED ON:

(a)

OBSERVATION SHEETS 12, 199,590				
FIELD BOOKPAGE #	SHEET		OF	3
SHOW A PLAN VIEW DRAWING DEPICTING THE CORNER MONUMENT AND PHYSICAL FEATURES, INCLUDING THE EXCAVATION AREA AND DEPTH.	SURRO	UNDING		
PLANNING & ZONING COMMITTEE ADOPTED THE ABOVE FORM ON 12/2/1982		•		

PL589

(B) Describe any record evidence, monument evidence, occupational evidence, testimonial evidence or any other material evidence you considered, and whether the monument was found or placed.

1833 HARRISON NORTH BET SECS 26 & 27

2640 QUARTER SEC COR (W.O. 36 S11E 59.4' W.O. 37 N22E 19.8' W.O. 36 WO 37) MARKED

3653.76 W.D. 36

5280 COR TO SECS 22 23 26 27 {W.O. 36 N59W 62.7' W.O. 16 N29E 75.9' W.O. 24 SB6E 247.5' W.O. 24 S57W 185.46' LAND ROLING 2ND RATE TIMBER W.O. & RED O ? ? & WEEDS

EAST ON RAND. BET. 23 & 26

1320 LEFT TIMBER & ENTER MARSH

2508 LEFT MARSH

2640 TEMPY 1/4 P

2805 LEFT TIMBER & ENTER MARSH

3300 LEFT MARSH & ENTER TIM.

3696 LEFT TIMBER & ENTER MARSH

514B LEFT MARSH & ENTER TIM.

5299.8 INT. E 8DB 52.8' S OF P. LAND LEVEL & WET 3RD
RATE TIMBER W.O. & BURR O

COR. WEST

2649.9 QUARTER SEC COR. {W.O. 24 N32E 214.5' W.O. 24 S29W 225.06' W.O 24 W.O. 24}MARKED

4620 W.O. 30

5299.8 SEC COR

NORTH BET. 22 & 23

2278.98 W.O. 18

2640 QUARTER SEC COR. {W.O. 24 N75W 33' BLK O 10 S25E 32.34' W.O. 24 BLK O 10} MARKED

3666.96 W.D. 18

5280 COR TO SECS 14 15 22 23 {BURR O 18 529E
70.62' BURR O 14 54W 79.2' BURR O 6 N79W
91.74' BLK O 11 N73E 186.78' LAND ROLLING
2ND RATE WITH TIMBER & BURR O BLK O. HICKY,
W.O. BUSHES, GRASS & WEEDS

EAST ON RAND. BET 22 & 27

1650 LEFT PRAIRIE & ENTER TIMBER

2640 TEMPY 1/4 P

5247 INT. E BDY AT P. LAND 1ST 1/4 1ST RATE ROLLING PRAIRIE RUN OF ? ROLLING 2ND RATE WITH BURR RED HASH & W.O. ? HAZEL W.O BUSHES GRASS & WEEDS

COR WEST

382.14 W.O. 24

2623.5 QUARTER SEC COR {BLK 0 24 684E 337.26 BLK 0 16 526W 275.22' BLK 0 24 BLK 0 16} MARKED

5247 SEC COR 1844 TWP RD REC BK 1 PG 3 COMMENCING AT THE NE COR OF THE W 1/2 OF THE NW 1/4 OF SEC 26 T2N R11E IN SAID TOWN NEAR THE HOUSE OF WALTER INMAN AND RUNNING WEST ON THE LINE BETWEEN SECTIONS 23 & 26, 1325.28 TO THE COR SECTIONS 22,23,26, AND 27 WHITE DAK 36 INCHES BEARS N59W 64.03' N29E 1.00'; THENCE WEST ON LINE BETWEEN SECTIONS 22 AND 27, 5247' TO THE COR OF SECTION 21,22 AND 27 AND 28 SET POST IN MOUND WHERE OLD POST STOOD; THENCE WEST ON LAND BETWEEN SECTIONS 21 AND 28, 5267.46' TO COR OF SECTIONS 20,21 AND 28 AND 29, SET POST IN MOUND SIGHT OF OLD POST, THENCE WEST ON LINE BETWEEN 20 AND 29 UNTIL IT INTERSECTS THE BELOIT AND MADISON RD. SAID RD IS LAID OUT 66' WIDE OR 33' ON EACH SIDE OF THE LINE.

1848 TWP RD REC BK 1 PG 23 & 24 BEGINNING AT THE 1/4 POST ON THE NORTH LINE OF SEC OF 11 OF T2, R11E OF THE 4TH P.M. AND RUNNING THENCE SOUTH 3960' ON THE LINE THROUGH THE CENTER OF SEC; THENCE RUNNING S17-30W

SHEET 1 OF 3 CORNER CODE R-17(1)

Porold Baines

1996.5' TO THE CENTER OF NEW BRIDGE OVER BASS CREEK AND RUNNING THENCE \$32-30W 1122' TO THE RD THROUGH THE CENTER OF THE W ½ OF SEC 14, SAME TWP AND RANGE. MAGNETIC VARIATION 6-30 EAST; THENCE SOUTH ON THE HALF QUARTER LINE TO THE SOUTHLINE OF SEC 14; THENCE WEST 1320' ON THE SEC LINE TO THE NW COR OF SEC 23; THENCE SOUTH ON THE SEC LINE BETWEEN COR OF SEC 23; THENCE SOUTH ON THE SOUTH LINE BETWEEN SECS 22 & 23 AND 26 AND 27,34, & 35 TO THE SOUTH LINE OF THE TOWN. SAID RD IS 66' IN WIDTH.

- 1853 TWP RD REC BK 1 PG 30 & 31""" HWY BE LAID OUT IN SAID TOWN OF THE WIDTH OF 66' WIDE AND HAVE CAUSED A SURVEY THERE OF TO BE MADE AS FOLLOWS: THE CENTER LINE OF THE SAID HWY IS TO COMMENCE 1320' EAST OF THE SW COR OF SEC 23; THENCE RUNNING EAST ON THE SEC LINE TO THE SW COR OF SEC 24; THENCE EAST 825' RUNNING 33' SOUTH AND PARALLEL WITH SECTION LINE BETWEEN SECS 24 AND 25; THENCE EAST ON THE SECTION LINE BETWEEN 24 AND 25 TO THE EAST LINE OF SAID TOWN.
- 1868 LOCKE PG 2 EAST BETWEEN SECS 23 & 26 VAR 6-25E AUG 17, 1868
 - 2659.14 INTERSECTED 1/4 LINE AT 1/4 COR FOUND STUMP OF SOUTH B.T. AND WHERE NORTH B.T. WAS DUG OUT AND OLD STAKE. COR IN CENTER OF HIGHWAY & 3' WEST OF FENCES RUNNING NORTH & SOUTH.

CONTINUED EAST FROM 1/4 COR WITH VAR 6-15
5330.16 INTERSECTED EAST BOUNDARY 15.18' SOUTH OF
COR. FOUND B.T.S IN SECS 24 & 25 AND STUMPS
OF BTS IN 23 AND 26 COR IN CENTER OF HIGHWAY
RUNNING WEST AND SOUTH AND 2 FT SOUTH OF
FENCE ON NORTH SIDE OF HIGHWAY RUNNING
EAST & 2 FT WEST OF FENCE RUNNING NORTH.
VAR CORRECTED 6-35

PG11 NORTH BETWEEN SECS 26 & 27 VAR 7-10
2660.79 INTERSECTED 1/4 LINE 2.64' EAST OF COR. FOUND
STUMPS OF NORTH B.T. AND STONE 0.66' NORTH
OF COR. VAR CORRECTED 7-13 COR IN CENTER
OF HIGHWAY

CONTINUED NORTH WITH VAR 7-25

- 5321.91 INTERSECTED NORTH BOUNDARY 4.29' WEST OF COR. VAR CORRECTED 7-19 AUG 19 1868 PG 23 NORTH BETWEEN SECS 22 & 23 VAR 7-12
- 2364.12 W D. LINE TREE
- 2650.56 INTERSECTED ¼ LINE 6.6' WEST OF COR. FOUND WEST BT AND OLD STAKE VAR CORRECTED 7-04

 SET OFF 15.18' EAST FROM ¼ COR AND

 CONTINUED NORTH WITH VAR 7-28
- 5305.08 INTERSECTED NORTH BOUNDARY 5.94' WEST OF COR. VAR CORRECTED 7 AUG 24, 1868
 PG 1 COMMENCED AT COR FOR SECS 21,22,27 & 28
 FOUND COR AS SET BY CHURCH SEE COUNTY
 SURVEYOR RECORD SEC 28 & UNDERNEATH
 REMAINS OF STAKE. COR IN CENTER OF
 HIGHWAY & IN LINE WITH FENCE RUNNING
 SOUTH. EAST BETWEEN SECS 22 & 27 VAR 6-15
- 2644.95 INTERSECTED 1/4 LINE AT 1/4 COR. FOUND WEST BT AND STUMP OF EAST BT AND OLD STAKE. COR IN CENTER OF HIGWAY AND IN LINE WITH NORTH AND SOUTH FENCES.
- CONTINUED EAST FROM 1/4 COR VAR 6
 5279.01 INTERSECTED EAST BOUNDARY 9.9' NORTH OF
 COR

SHEET 2 OF 3 CORNER CODE R-17(1)

Darold Bornes

3-07-03

FOUND BTS IN SECS 23 & 27 & STUMPS OF BTS IN 22 & 26 DIST. TO BT IN 27 IS 163.35' DIST. TO STUMP OF BT IN 26 IS 217.8' COR IN CENTER OF HIGHWAY VAR CORRECTED 5-47 AUG 17, 1868

- 1869 LEE VOL 1 PG 338 FD MON. 2662.44 TO N 1/4 COR SEC 26 & VAR 7 2660.13 TO W 1/4 COR SEC 26
- 1870 RUGER VOL 2 PG 47 STONE MON. BY LOCKE. VAR 6-35 2660.62 TO S 1/4 COR SEC 23 & VAR 6-32 2646.93 TO W 1/4 COR SEC 23
- 1876 RUGER VOL 2 PG 206 STONE MON. VAR 4-46 2628.78 TO N COR SEC 27 & 2655.84 TO E $\frac{1}{4}$ COR SEC 27.
- 1968 BATTERMAN VOL 4 PG 370 DUG 8X8 HOLE FD NOTHING.
- 1979 BARNES VOL 6 PG 11 FORMER COUNTY DUG FD NOTHING.
 SET ALUM. AT PRORATED DISANCE FROM ¼ CORNERS. USED
 LOCKES 1868 MEASUREMENTS FOR PRORATION. (BEARINGS
 SHOWN ARE VOID BY VOL 6 PG 280) 2635.14 TO
 S ¼ COR SEC 22, 2660.24 TO S ¼ COR SEC 23, 2658.64 TO E
 ¼ COR SEC 27 & 2648.09 TO E ¼ COR SEC 22.
- 1979 BARNES VOL 6 PG 280 VOID BEARINGS ON PAGE 11 VOL 6
 THE FOLLOWING BEARINGS (ASSUMED NORTH) ARE
 CORRECT:

N87-38-27W TO S $\frac{1}{4}$ COR SEC 22, S89-20-12E TO S $\frac{1}{4}$ COR SEC 23, S0-01-01E TO E $\frac{1}{4}$ COR SEC 27, & N0-11-11E TO E $\frac{1}{4}$ COR SEC 22.

- 1981 BARNES R-21 2660.33 TO N 1/4 COR SEC 26.
- 1982 BARNES VOL 6 PG 282 NO-34-16W 2647.77 TO W 1/4 COR SEC 23 & N89-53-47E 2660.33 TO S 1/4 COR SEC 23
- 1983 COMBS CSM VOL 11 PG 216 FD ALUM. MON.
- 1990 BARNES VOL 6 PG 409 THE EAST LINE OF THE NE 1/4 OF SEC 27 SHOULD BE NO-09-33W
- 1991 BARNES R-17 ROAD PAVING PROJECT WILL INVOLVE THIS CORNER. DID NOT ACCEPT NOR REJECT FD ALUM. MON. REFERENCED FD MON SO IT WOULD NOT BE DESTROYED BY THE PAVING PROJECT. SHOWS OLD LIMITS OF EXCAVATION. MON IS 1.5' EAST OF N/S CENTER OF PVMT & 2.6' N OF E/W CENTER OF PVMT.
- 1992 COMBS CSM VOL 16 PG D1 ALUM 2660.19 TO ALUM @ N 1/4 COR SEC26
- 1993 OFS CSM VOL 17 PG 58 STATES NOTHING ABOUT MON.
- 1998 OFS CSM VOL 22 PG 38 STATES NOTHING ABOUT MON.
- 2001 COMBS CSM VOL 24 PG 330 & 360 FD ALUML 2660.35 TO N $^{1\!/_{\!\!4}}$ COR SEC 26.

FD ALUM. MON. 3' NORTH OF E/W CENTER OF PVMT. & 1.8' EAST OF N/S CENTER OF PVMT.

C) Was the corner restored through acceptance of (1) an obliterated evidence location, or, (2) a found perpetuated location?

ACCEPTED FD ALUM. MON. P Fd TIES

I, **Donald Barnes**, hereby certify that the corner location as identified by the corner code index was determined by me under my direction and control and that this U.S. Public Land Survey Monument Record is correct and complete to the best of my knowledge and belief.

Seal

SHEET 3 OF 3

Donald Booker
Emboss 3-07-03

CORNER CODE R-17(1)