U.S.


LAND **PUBLIC** SURVEY MONUMENT RECORD

For Public Land Survey Corners in:

WI ADMINISTRATIVE CODE A-E 7.08 REQUIREMENT

. T.∠N., R. //_E

CORNER CODE INDEX

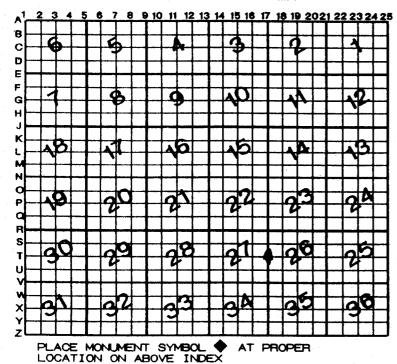

PLYMONTH ROCK COUNTY WI

IF AVAILABLE ROCK COUNTY COORDINATES PERFERRED

North Elev. East Hor. Datum _____ Vert. Datum LATITUDE __ ELLIPS. HT.

GPS (X) _ TRAVERSE (X) BASED ON THE FOLLOWING CONTROL:

♦CORNER MONUMENT

O WITNESS MONUMENT

LONGITUTE

(a)

BASED ON: BEARINGS ARE

OBSERVATION	SHEETS	719190
		, , , , , , , , , , , , , , , , , , ,

FIELD	В	оок _		PAGE #	¥				9	SHEET	
SHOW	Ä	PLAN	VIEW	DRAWING	DEPICTING	THE	CORNER	MONUMENT	AND	SURRO	UNDING
PHYSIC	AL	- FEAT	URES,	INCLUDING	THE EXC	AVAT	ION AREA	AND DEPT	TH.		
-	_										

PL598

A Section

(B) Describe any record evidence, monument evidence, occupational evidence, testimonial evidence or any other material evidence you considered, and whether the monument was found or placed.

1833 HARRISON NORTH BET SECS 26 & 27

2640 QUARTER SEC COR (W.O. 36 S11E 59.4' W.O. 37 N22E 19.8' W.O. 36 WO 37 MARKED

3653.76 W.O. 36

5280 COR TO SECS 22 23 26 27 (W.O. 36 N59W 62.7' W.O. 16 N29E 75.9' W.D. 24 S86E 247.5' W.D. 24 S57W 185.46' LAND ROLLING 2ND RATE TIMBER W.O. & RED O ? ? & WEEDS

1865 LOCKE MAP #04404

1867 LOCKE VOL 1 PG 248 FD STUMP OF W. B TREE & E. B TREE DUG OUT WITH L.S. O.66' N OF COR. VAR 6-30 TO CENTER SEC 26 & 5342.04 TO E 1/4 COR SEC 26.

1868 LOCKE PG11 NORTH BETWEEN SECS 26 & 27 VAR 7-10 INTERSECTED 1/4 LINE 2.64' EAST OF COR. FOUND 2660.79 STUMPS OF NORTH B.T. AND STONE 0.66' NORTH OF COR. VAR CORRECTED 7-13 COR IN CENTER OF HIGHWAY

CONTINUED NORTH WITH VAR 7-25

INTERSECTED NORTH BOUNDARY 4.29' WEST OF COR. 5321.91 VAR CORRECTED 7-19 AUG 19 1868

1869 LEE VOL 1 PG 338 FD MON VAR 7 2660.13 TO NW COR SEC 26, VAR 6-55 2663.10 TO SW COR SEC 26, & VAR 6-23 2669.04 TO CENTER OF SEC 26

1876 RUGER VOL 2 PG 206 MON. 2655.84 TO NE COR SEC 27. VAR 4-46 2636.70 TO CENTER SEC 27, & 5275.71 TO W 1/4 COR **SEC 27**

1968 BATTERMAN VOL 4 PG 370 FD CUT STONE 3.5' DEEP. REF. SAME. 1 1/2 N OF E/W FENCE

1979 BARNES VOL 6 PG 11 SHOWS BEARINGS WHICH ARE VOID IN VOL 6 PG 280. 2658.64 TO NE COR SEC 27. @ E $1/16^{TH}$ COR OF SE 1/4 SEC 22 THE DISTANCE TO THE SE COR SEC 22 IS 1323.19 & THE DISTANCE TO THE E $\frac{1}{4}$ COR SEC 22 IS 1324.90 & THE ANGLE FROM THE E 1/4 COR SEC 22 TO THE SE COR SEC 22 IS 180-08-00

1979 BARNES VOL 6 PG 280 BEARINGS IN VOL 6 PG 11 ARE VOID. FOLLOWING ANGLES @ NE COR SEC 27

ANGLE

FS

BS

92-22-34 89-19-11 E 1/4 COR 27

N 1/4 SEC 27

179-47-48

N 1/4 COR 26

E 1/4 COR 27

E 1/4 COR 22 E 1/4 COR 27

1982 COMBS CSM VOL 11 PG 271

1990 BARNES VOL 6 PG 409 VOL 6 PG 11 EAST LINE OF NE 1/4 SEC 27 SHOULD BE NO-09-33W. {ANGLE @ NE COR SEC 27 FROM E 1/4 COR SEC 22 TO E 1/4 COR SEC 27 179-30-41}

1991 BARNES T-17 ROAD PAVING PROJECT WILL INVOLVE THIS CORNER. DID NOT ACCEPT NOR REJECT FD ALUM. MON. REFERENCE FD MON SO IT WOULD NOT BE DESTROYED BY THE PAVING PROJECT. 1' WEST OF CENTER LINE OF PVMT. & ON LINE WITH E/W FENCES.

> CORNER CODE T-17(1) SHEET 1 OF 2

Devold Barnes 3-07-03

PL598

1996 COMBS CEMETERY PLATS VOL 1 PG 62 "3" ADDITION TO HANOVER CEMETERY" 3" ROUND ALUM. 2660.16 TO SE COR SEC 27

FD ALUM, MON, 1' WEST OF CENTER OF PVMT. & REFERENCE TIES

C) Was the corner restored through acceptance of (1) an obliterated evidence location, or, (2) a found perpetuated location?

ACCEPTED THE ALUM. MON. WHICH PERPETUATED THE CUT L.S.

- D) Describe any material discrepancy between the location of the corner as restored or reestablished and the location of that corner as previously restored or reestablished by distance and direction. Show the discrepancy on the plan view drawing under (a), above. Show the distances between the corner as previously restored or reestablished and (1) the corner as restored or reestablished, and (2) to at least 4 of the witness monuments shown on the drawing in (a), above.
- (E) Was the corner reestablished through lost corner proportionate methods? If so, show the method, including the directions and distances to other public land survey corners used as evidence or used for proportioning the corner location.
- I, **Donald Barnes**, hereby certify that the corner location as identified by the corner code index was determined by me under my direction and control and that this U.S. Public Land Survey Monument Record is correct and complete to the best of my knowledge and belief.

3-07-03

SHEET 2 OF 2

CORNER CODE T-17(1).

A-E 7.08 REQUIREMENT