
U.S. PUBLIC LAND SURVEY MONUMENT RECORD

For Public Land Survey Corners In:

WI ADMINISTRATIVE CODE A-E 7.08 REQUIREMENT

T. AN. R. 13E.

CORNER CODE INDEX

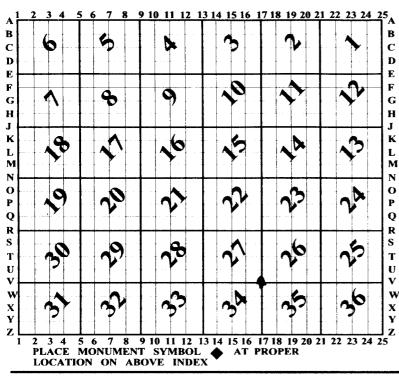

MILTON TWP
ROCK COUNTY WI

IF AVAILABLE
ROCK COUNTY COORDINATES PERFERRED

North _____ Elev. ____

East _____

Hor. Datum _____ Vert. Datum _____

LATITUDE _____ ELLIPS. HT.

LONGITUDE _____

GPS (X) ____ TRAVERSE (X) _

BASED ON THE FOLLOWING CONTROL:

♦ CORNER MONUMENT

O WITNESS MONUMENT

BEARINGS ARE BASED ON:_______

(a)

FIELD BOOK _____ PAGE # ____ SHEET _/ OF ____ SHOW A PLAN VIEW DRAWING DEPICTING THE CORNER MONUMENT AND SURROUNDING PHYSICAL FEATURES, INCLUDING THE EXCAVATION AREA AND DEPTH.
PLANNING & ZONING COMMITTEE ADOPTED THE ABOVE FORM ON 12/2/1982

CORNER CODE V-17 (4)

MISOS

- (B) Describe any record evidence, monument evidence, occupational evidence, testimonial evidence or any other material evidence you considered, and whether the monument was found or placed.
- 1871 RUGER REMON. PROJ. PG 289 & 290 NORTH ON WEST LINE OF SW 1/4 OF SEC 35 ON A VAR 7-15 OFFSET EAST 6.60'
 - 2647.92 INTERSECTED ¼ LINE 6.60' EAST OF ¼ COR FOUND OLD STAKE AT COR

NORTH ON WEST LINE OF NW 1/4 OF SEC 35 ON A VAR 7-15 OFFSET EAST 10.56'

2649.08 INTERSECTED NORTH BOUNDARY LINE 10.56' EAST OF COR.

PG 275 EAST ON NORTH LINE OF NW 1/4 OF SEC 34 ON A VAR 3-43

2628.45 INTERSECTED ¼ LINE 5.28' SOUTH OF ¼ COR FOUND OLD STAKE AT COR ALSO FD NW & SE BEARING TREES COR VAR 3-49

EAST ON NORTH LINE OF NE 1/4 OF SEC 34 ON A VAR 3-55

2627.46 INTERSECTED EAST BOUNDARY LINE 9.9' NORTH OF COR. FOUND OLD STAKE SURROUNDED BY STONES AT COR. COR VAR 3-42

EAST ON NORTH LINE OF NW 1/4 OF SEC 35 ON A VAR 4-30

2653.53 INTERSECTED ¼ LINE 4.62' NORTH OF ¼ COR FOUND OLD STAKE AT COR. ALSO FO STUMP OF BEARING COR VAR 4-24

EAST ON NORTH LINE OF NE ¼ OF SEC 35 ON A VAR 5-00

2665.58 INTERSECTED EAST BOUNDARY LINE 6.6' NORTH OF COR. FO LIMESTONE AT COR AND STUMPS OF NE & SW BEARING TREES. COR VAR 4-51

PG 290 NORTH ON WEST LINE OF SW 1/4 OF SEC 26 ON A VAR 7-10 OFFSET WEST 6.6', OFFSET EAST 52.8', OFFSET EAST 118.8'

- 2647.92 INTERSECTED 1/4 LINE 138.6' EAST OF COR

 NORTH ON WEST LINE OF NW 1/4 OF SEC 26 ON A

 VAR 7-10
- 2649.08 INTERSECTED NORTH BOUNDARY LINE 4.62' EAST OF COR COR VAR 4-16
- 1873 LEE VOL 2 PG 100 STATES NOTHING BUT CALLS FOR 2650.56 TO N ¼ COR SEC 35.
- 1913 KERCH VOL 5 PG 494 STATE "MON" 2652.66 TO 5 ¼ COR SEC 26 & ANGLE OF 92-53-38 @ SW COR SEC 26 FROM W ¼ TO S ¼ CORNERS OF SEC 26. NW 87 TO COR HSE, SW 43 TO SOFT MAPLE, SE 44 TO SOFT MAPLE, & NE 47.5 TO TELE POL #4635
- 1927 UNKOWN VOL 3 PG 144 STATES NOTHING BUT SET TIES IN UTILITY POLES
- 1931 SUNNY VOL 3 PG 198 FD BOLT IN CONCRETE 33' SOUTH OF PROPERTY LINE. ANGLE 92-33 AT SW COR SEC 26 FROM WEST LINE TO SOUTH LINES OF SEC 26.
- 1933 SUNNY VOL 3 PG 238 STATES NOTHING BUT CALLS FOR 2628.14 TO 5 1/4 COR SEC 27
- 1972 NORTHROP VOL 6 PG 298 2653.95 TO 5 ¼ COR SEC 26 & THE FOLLOWING ANGLES:

@ 88 FS ANGLE 87-07-12 W 1/4 COR SEC 26 CENTER 26 SW COR 26 92-52-40 SW COR SEC 26 W 1/4 26 5 1/4 COR 26 87-04-05 S ¼ COR SEC 26 5W 26 **CENTER 26** 179-53-41 S ¼ COR SEC 26 SW 26 **SE SEC 26**

- 1975 BARNES VOL 5 PG B6 FD PK & REFERENCED TO UTILITY POLES & TREE.
- 1983 BARNES V-17 FD ALUM. SET TIES
- 1983 WIDOT STH59 R/W PLANS PROJECT #3143-00-21 SHEET 4.4.
 PK NAIL OVER BOLT 283,455.01; 2,285,743.40

SHEET 1 OF 3

V-17(4)

Jord Barnes \$/06/2002

MI609

1983 WIDOT V-17(1) PK OVER BOLT STA 90+18.26. SET TIES. 1994 BARNES V-17(2) NADB3(1991) COORDINATES WERE PROVIDED BY STRAND ASSOCIATES FOR STH 26 PROJECT. CONVENTIONAL TRAVERSE WAS USED TO CONNECT SECTION CORNERS TO WIDOT'S GPS STATIONS. I USED STRANDS'S STATE PLANE COORDINATES TO COMPUTE THE COUNTY COORDINATE-301,897.43 N/S; 516,602.89 E/W. THE TOWNSHIP PROJECT COORDINATES ARE 301,897.30; 516,602.88 1996 WOOD VOL 6 PG 451 WIDOT PROJECT 1390-03-21 FD ALUM. NAD83(1991) 283,462.41N/S; 2,254,205.77 E/W 1996 BARNES V-17(3) FD PK THAT AGREED WITH TIES @ CENTER OF PVMT.

IN SEP & NOV 2001 FD PK & OLD & NEW WIDOT TIES. PAVING PROJECT WILL PROBABLY DESTROY MONUMENT WITHIN A FEW MONTHS. APR 2002 FD OLD & NEW WIDOT TIES. DUG & FD BOLT 0.7' DEEP 0.7' SOUTH OF CENTER OF PVMT. PLACED 2 MAGNETS AROUND BOLT & PLACED ALUM. EXTENSION MONUMENTS ON TOP OF BOLT.

C) Was the corner restored through acceptance of (1) an obliterated evidence location, or, (2) a found perpetuated location?

ACCEPTED FOUND BOLT. RECORD DISTANCES TO REFERENCE MONUMENTS ARE IN HARMONY WITH NEW DISTANCES.

- D) Describe any material discrepancy between the location of the corner as restored or reestablished and the location of that corner as previously restored or reestablished by distance and direction. Show the discrepancy on the plan view drawing under (a), above. Show the distances between the corner as previously restored or reestablished and (1) the corner as restored or reestablished, and (2) to at least 4 of the witness monuments shown on the drawing in (a), above.
- (E) Was the corner reestablished through lost corner proportionate methods? If so, show the method, including the directions and distances to other public land survey corners used as evidence or used for proportioning the corner location.
- I, Donald Barnes, hereby certify that the corner location as identified by the corner code index was determined by me under my direction and control and that this U.S. Public Land Survey Monument Record is correct and complete to the best of my knowledge and belief.

Seal

Portes Barres 5/06/2002

SHEET 2 OF 3

CORNER CODE

V-17(4)

A.E. 7.08 REQUIREMENT

