

# U.S. PUBLIC LAND SURVEY MONUMENT RECORD

For Public Land Survey Corners in:

WI ADMINISTRATIVE CODE A-E 7.08 REQUIREMENT

T. L N., R. 12E 4th P.M.

CORNER CODE INDEX

A	1	2	3	4	5	6	7	8	9	10	11	12	13	14	15	16	17	18	19	20	21	22	23	24	25
B																									
C	6																								
D																									
E																									
F																									
G	7	8																							
H																									
J																									
K	18	17																							
L																									
M																									
N																									
O	19	20																							
P																									
Q																									
R																									
S																									
T	30	29																							
U																									
V																									
W																									
X	31	32																							
Y																									
Z																									

TWP  
**ROCK COUNTY, WI**

IF AVAILABLE  
ROCK COUNTY COORDINATES PREFERRED

North 233,233.38 Elev. \_\_\_\_\_

East 488,556.98

Hor. Datum County Vert. Datum \_\_\_\_\_

LATITUDE \_\_\_\_\_ ELLIPS. HT. \_\_\_\_\_

LONGITUDE \_\_\_\_\_

ELLIPS. DATUM  
NAD83(91) \_\_\_\_\_ COUNTY \_\_\_\_\_ LIST \_\_\_\_\_

GPS (X) \_\_\_\_\_ TRAVERSE (X) \_\_\_\_\_

BASED ON THE FOLLOWING CONTROL:

PLACE MONUMENT SYMBOL **◆** AT PROPER LOCATION ON ABOVE INDEX

**◆** CORNER MONUMENT

WITNESS MONUMENT

(a) BEARINGS ARE BASED ON:

FIELD BOOK \_\_\_\_\_ PAGE # \_\_\_\_\_

SHEET 2 OF 2

SHOW A PLAN VIEW DRAWING DEPICTING THE CORNER MONUMENT AND SURROUNDING PHYSICAL FEATURES, INCLUDING THE EXCAVATION AREA AND DEPTH.

PLANNING & ZONING COMMITTEE ADOPTED THE ABOVE FORM ON 12/2/1982

CORNER CODE A-19(1)

BE510

(B) Describe any record evidence, monument evidence, occupational evidence, testimonial evidence or any other material evidence you considered, and whether the monument was found or placed.

- 1833 MULLETT EAST ON SOUTH SIDE SECTION 35  
2640 SET QUARTER SECTION POST IN PRAIRIE AND RAISED A MOUND  
5280 SET POST CORNERS SECTION 35 & 26 AND RAISED A MOUND.  
SEP 1833
- 1860 RUGER VOL 1 PG 129. PLACED LIMESTONE 10 X 5 X 2 1/2. SHOWS 2623.83 TO NE & NW CORNERS OF SECTION 2 AND ON LINE WITH THOSE CORNERS. SHOWS 2987.82 TO CENTER OF SECTION 2. CENTER OF SEC 2 IS EQUAL DISTANCE BETWEEN E & W 1/4 CORNERS.
- 1934 BATTERMAN #164 FD LIMESTONE NOT SQUARE WITH WORLD. REFERENCED L.S & CORNER THEY SET. THE LIMESTONE IS 3.3 NORTH & 1.1 EAST OF THEIR CORNER. CALL FOR 2639.63 TO NW COR OF SEC 2. CALL FOR 1319.26 TO STONE & WOOD STAKE
- 1965 BATTERMAN JR. VOL 4 PG 170. FOUND PIN. SET MONUMENT BOX & REFERENCED SAME.
- 1965 DOT A-19 ADJUSTABLE MONUMENT. 1" PIPE DRIVEN BY BATTERMAN ENGINEER. SHOWS TIES & STATION 79+61.61. NOTE: ALL MEASUREMENTS FROM WITNESS MONUMENT TO LANDMARK WERE TAKEN TO ORIGINAL PIN LOCATED IN THE OLD PAVEMENT PRIOR TO GRADING OPERATIONS ON OR ABOUT APRIL 21, 1965.
- 1979 BARNES VOL 5 PG 576 FOUND MONUMENT BOX. SHOWS WEST OF SOUTH QUARTER CORNER SECTION 35. N88-21-35E 2639.17 TO SW CORNER OF SECTION 35 AND N88-22-36E 2495.88 TO NORTHEAST CORNER OF SECTION 2. THE BOX AT THE NE CORNER OF SEC 2 IS ERRONEOUS.
- 1980 BARNES VOL 6 PG 15 FOUND ALUMINUM MONUMENT.
- 1990 BARNES Z19 FOUND 1" PIPE IN MONUMENT BOX. REFERENCED SAME.  
N84-05-34E 13.08 TO S 1/4 COR SEC 35.

FD ALUM AT S 1/4 COR SEC 35 AND 1' PIPE IN MON BOX 13.08 TO THE WEST.

C) Was the corner restored through acceptance of (1) an obliterated evidence location, or, (2) a found perpetuated location?

ACCEPTED FOUND PERPETUATED MONUMENT.

D) Describe any material discrepancy between the location of the corner as restored or reestablished and the location of that corner as previously restored or reestablished by distance and direction. Show the discrepancy on the plan view drawing under (a), above. Show the distances between the corner as previously restored or reestablished and (1) the corner as restored or reestablished, and (2) to at least 4 of the witness monuments shown on the drawing in (a), above.

I, Donald Barnes, hereby certify that the corner points as identified by the corner code index were, in a field survey on, established, re-established, monumented, re-monumented, recovered or restored as expressed below and in conformance with the regulations and rules as required in the current manual of survey instructions of the United States Department of Interior, Bureau of Land Management.

COUNTY SURVEYOR FILING DATA

seal

Date of computer entry \_\_\_\_\_

Date microfilmed \_\_\_\_\_

Number of included sheets \_\_\_\_\_


CORNER CODE

AFFIX YOUR LAND SURVEYOR SEAL

*Donald Barnes*  
*Oct 9, 1998*

*A-19(1)*

R/W POST

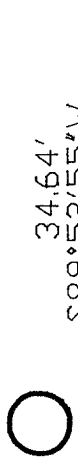

FD 2" PIPE

34.64'  
S89°52'55"W

3/4X24 REROD  
WITH ORANGE PLASTIC CAP

N20°28'00"W 57.93'  
N30°43'38"E 57.93'  
N30°43'38"E 57.93'  
S18°53'43"W 51.21'

49.98' S5°47'17"E

FD 1" PIPE  
IN MON BOX

FD ALUM.

TOWN LINE RD N 1/4 COR  
SEC 2

S 1/4 COR  
SEC 35

13.08'  
S84°05'34"W

S19°26'34"W 115.87'  
S36°13'18"W 73.80'  
N42°55'26"E 83.15'


N7°04'02"W 59.57'

S5°22'18"W 60.74'  
N11°33'20"E 111.17'

N89°31'52"E 50.94'

3/4X24 REROD  
WITH ORANGE PLASTIC CAP

3/4X24 REROD  
WITH ORANGE PLASTIC CAP

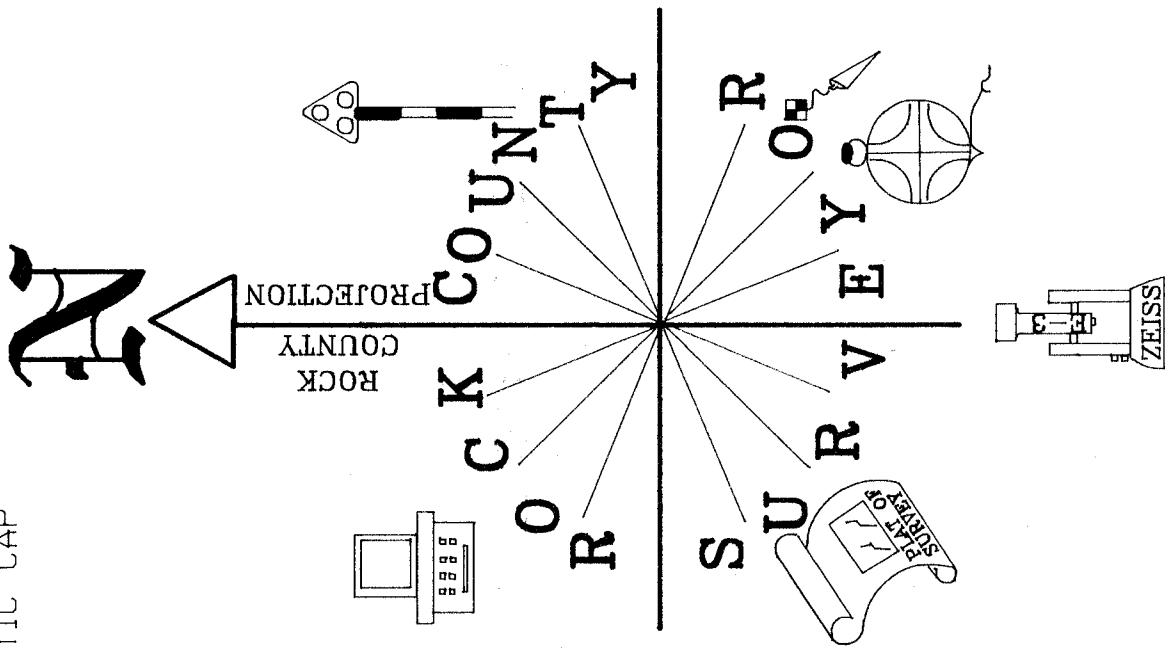

Donald Barnes  
Oct 9, 1998

A-19 (1)