(mumtn:

LAND PUBLIC

Black non

required

MONUMENT RECORD


VEY SUR

For Public Land Survey Corners in:

WI ADMINISTRATIVE CODE A-E 7.08 REQUIREMENT

T. ZN., R. _//_E

CORNER CODE INDEX

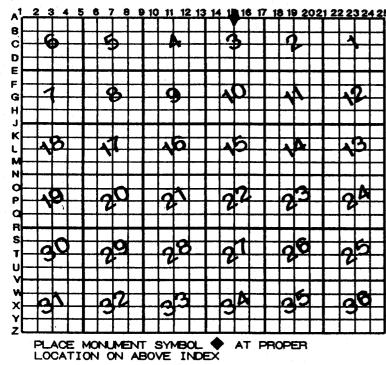

PLY	M	0	V	711	<u></u> T	W	P
ROCI							

IF AVAILABLE ROCK COUNTY COORDINATES PERFERRED

North	Elev			
East	***************************************			
Hor. Datum	Vert. Datum			
LATITUDE	ELLIPS. H			
LONGITUTE				
GPS (X)	TRAVERSE (X)			
BASED ON THE	FOLLOWING CONTROL:			

♦CORNER MONUMENT

O WITNESS MONUMENT

BEARINGS ARE BASED ON:

(a)

6	BSERV	ation	SHEETS

FIELD BOOK. .PAGE # SHEET

SHOW A PLAN VIEW DRAWING DEPICTING THE CORNER MONUMENT AND SURROUNDING PHYSICAL FEATURES, INCLUDING THE EXCAVATION AREA AND DEPTH. PLANNING & ZONING COMMITTEE ADOPTED THE ABOVE FORM ON 12/2/1982

CORNER CODE A-15 (3)

PL508

(B) Describe any record evidence, monument evidence, occupational evidence, testimonial evidence or any other material evidence you considered, and whether the monument was found or placed.

1833 MULLETT

WEST ON SOUTH SIDE SECTION 34

2640 SET QUARTER SECTION POST IN PRAIRIE AND

MADE MOUND

5280 SET POST CORNER SECTIONS 33 & 34 IN PRAIRIE

AND MADE MOUND LAND ROLLING PRAIRIE

SECOND RATE.

1855 CHURCH VOL 1 PG 39 STONE 18" LONG 4" THICK LOCUST 4 S5W 600.27' YELLOW OAK 16 N13W 543. USED CORNER TO SUBDIVIDE SECTION 3. SHOWS A DISTANCE OF 2638.35 TO THE CENTER OF SECTION 3 FROM E & W 1/4 CORNERS.

1868 LOCKE REMONUMENTATION FIELD NOTES, PLACED CUT LIMESTONE.

PG 48 WEST ON NORTH LINE SEC 3 VAR 7

2668.05 INTERSECTED 1/4 LINE FOR SEC 34 TOWN 3 N AT COR. FOUND OLD STAKE IN CENTER OF HIGHWAY AND IN LINE OF FENCES RUNNING NORTH AND SOUTH.

2654.85 SET 1/4 COR 13.2' EAST OF 1/4 COR. FOR TOWN 3 THE SEC. CORS WEST BEING LOST.

CENTER SLUICE BRIDGE 5.28' WIDE 2979.9

4068.9 **CENTER SLUICE BRIDGE 5.28' WIDE**

5300.13 INTERSECTED WEST BOUNDARY 12.62' SOUTH OF COR. SET AS PREVIOUSLY STATED (PAGE 47) VAR CORRECTED 6-44 MARKED 1/4 MONUMENT WITH FIGURE 3 ON SOUTH FACE. SEPT 3 1868

1886 RUGER VOL 2 PG 272 USED TO SUBDIVIDE SECTION 3 BUT STATES NOTHING ABOUT THE CORNER. SHOWS A DISTANCE OF 2648.42 & VAR 4-35 FROM E 1/4 COR SEC 3 TO THE CENTER OF SECTION 3.

1933 SUNNY VOL 3 PG 235 SHOWS TIES TO CORNER AND STATES "THIS 1/4 CORNER IS GONE. NOW GRAVEL PIT FILLED WITH ASHES. DUG AND FOUND 3 imes 6 imes 12 LIMESTONE 4' DEEP."

1970 BATTERMAN VOL 4 PG 484 SHOWS CORNER REFERENCED.

1972 SHIMEALL VOL 3 PG 235 NOTE STATES THAT HE PLACED A 1" PIPE.

1982 LEE CSM11-131 FD PK

1988 BARNES A-15 & Z-15 FD REROD AT ROAD SURFACE. 6" DEEP FOUND PIPE IN CONCRETE PAVEMENT. 34" DEEP FOUND CUT LIMESTONE. PLACED MAGNET ON TOP OF STONE. ACCEPTED FOUND CUT LIMESTONE. PIPE IS N50-40-29E 0.10' & THE REROD IS N86-20-24E 0.17' REFERENCED SAME. EXCAVATION FOR S 1/4 COR SEC 34 CENTER TWP IS SHOWN WEST OF LIMESTONE. S 1/4 COR SEC 34 CENTER TWP PLACED ON LINE WITH N 1/4 COR SEC 3 AND NW COR SEC 3 AT RECORD DISTANCE WHICH IS S88-56-44W 13.20' OF THE CUT L.S. @ N 1/4 COR SEC 3 PLYMOUTH TWP.

1989 WIDOT STH 11 MAP #16698 PROJECT 1704-03-22 CUT LIMESTONE 246,064.92; 2,220,619.41 S88-56-43W 13.20 TO S 1/4 COR SEC 34 MON TO BE SET 246,064.68; 2,220,606.21

1992 BARNES A-15(1) & Z-15(1) MONUMENT WILL BE DESTROYED BY CONSTRUCTION. REFERENCED SAME. S 1/4 COR 34 CENTER TWP IS S89-00-06W 13.20' (REC 13.20). @ S 1/4 COR SEC 34 CENTER TWP DOT DID NOT INSTALL A MON. ACCEPTED LOCATION AS PERPETUATED BY RECORD TIE DISTANCES.

1992 BARNES A-15(2) FOUND DOT DISK. ACCEPTED FOUND CUT LIMESTONE. DID NOT ACCEPT DOT DISK. DISK IS 0.06' NORTH AND 0.04' EAST OF THE CORRECT POSITION. FOUND PREVIOUS REFERENCE MONUMENTS.

SHEET 1 OF 2 CORNER CODE A-15(3)

Denald Bounes 6-17-03

PL508

1993 COMBS CSM VOL 17 PG 75 DOT MON. 2658.31 TO NW COR SEC 3 & ANGLE 178-00-20 @ S 1/4 COR SEC 33 FROM N 1/4 COR SEC 4 TO N 1/4 COR SEC 3.

Fd TIES

C) Was the corner restored through acceptance of (1) an obliterated evidence location, or, (2) a found perpetuated location?

USED MY OLD OBSERVATIONS. ACCEPTED FOUND CUT LIMESTONE

D) Describe any material discrepancy between the location of the corner as restored or reestablished and the location of that corner as previously restored or reestablished by distance and direction. Show the discrepancy on the plan view drawing under (a), above. Show the distances between the corner as previously restored or reestablished and (1) the corner as restored or reestablished, and (2) to at least 4 of the witness monuments shown on the drawing in (a), above.

AS PREVIOUSLY STATED & SHOWN ON SKETCH, THE WIDOT DISK DOES NOT FIT THE REFERENCE MONUMENTS.

- (E) Was the corner reestablished through lost corner proportionate methods? If so, show the method, including the directions and distances to other public land survey corners used as evidence or used for proportioning the corner location.
- I, Donald Barnes, hereby certify that the corner location as identified by the corner code index was determined by me under my direction and control and that this U.S. Public Land Survey Monument Record is correct and complete to the best of my knowledge and belief.

mald farmes

SHEET 2 OF 2

Emboss 6-17-03

CORNER CODE A-15(3) A-E 7.08 REQUIREMENT