Paper weigh

ninimum)


Black norman

## U.S. PUBLIC LAND SURVEY MONUMENT RECORD

For Public Land Survey Corners in:

T. 1 N., R. 12 E

CORNER CODE INDEX

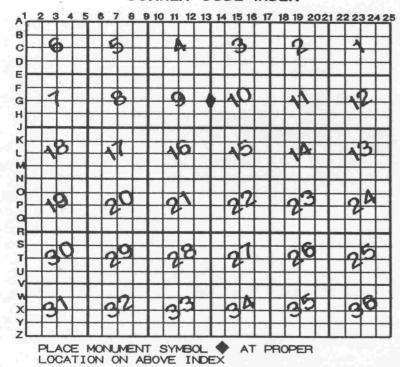

WI ADMINISTRATIVE CODE A-E 7.08 REQUIREMENT

## ROCK COUNTY WI

IF AVAILABLE ROCK COUNTY COORDINATES PERFERRED

North 225,054,95 Elev.

Hor. Datum County Vert. Datum \_

LATITUDE \_\_\_\_\_ ELLIPS. HT.

LONGITUTE

GPS (X) \_\_\_

TRAVERSE (X) \_

BASED ON THE FOLLOWING CONTROL:

**♦** CORNER MONUMENT

O WITNESS MONUMENT

BASED BEARINGS ARE

(a)

	1 2
FIELD BOOKPAGE #	SHEET $\sqrt{\text{OF }2}$
SHOW A PLAN VIEW DRAWING DEPICTING THE CORNER MONUMENT	AND SURROUNDING
PHYSICAL FEATURES, INCLUDING THE EXCAVATION AREA AND DEPTI	H.
PLANNING & ZONING COMMITTEE ADOPTED THE ABOVE FORM ON 12/2/1982	

CORNER CODE G-13(1

BE537

Describe any record evidence, monument evidence, occupational evidence, testimonial evidence or any other material evidence you considered, and whether the monument was found or placed.

1834 HARRISON NORTH BETWEEN SECTIONS 9 & 10

LEAVE PRAIRIE & SET CORNER TO QUARTER SEC IN TIMBER RED OAK 12 N78W 30.36' RED OAK S62E 33.66'

2831.4 WHITE OAK 12 IN DIAM. HICKORY 10 IN DIAM 3217.5 3758.7 WHITE OAK 12 IN DIAM.

4224 LEAVE TIMBER & ENTER PRAIRIE

5280 SET POST FOR COR TO SECS 3,4,9,& 10

RAISED MOUND OF SOD ON GROUND DESCENDING NORTH TO CREEK 1851 McVEAN VOL 1 PG 2 2695.44 TO CENTER SEC 10 & 5305.08 TO E 1/4 COR

SEC 10.

1948 BATTERMAN MAP #193 2663 TO NE COR SEC 9.

195? BATTERMAN VOL 3 PG 542 FD 1" PIN & REFERENCED SAME. FD A TOTAL OF 3 MONUMENTS & REFERENCED ALL.

1959 SHIMEALL MAP #253 FOUND PIPE.

1963 BATTERMAN VOL 4 PG 171 FD 1" PIN SET BY C. SHIMEALL. SET MON BOX.

1965 LEE MAP #232 FOUND PIPE IN MONUMENT BOX

1965 LEE CSM V1 PG 117 FOUND PIPE IN MON. BOX

1966 LEE CSM V1 PG 131 FOUND PIPE IN MON. BOX.

1966 BATTERMAN CSM V1 PG 142 FOUND PIPE IN MON. BOX

1966 BATTERMAN VOL 4 PG 291 MON BOX OVER PIN SET BY SHIMEALL. 2707.24 TO CENTER OF SEC 10 & 2654.38 TO SW COR SEC 10.

1968 LEE CSM V1 PG 162 CALLS FOR MON. BOX.

1970 SHIMEALL MAP #234 ANGLE OF 91-20 FROM SE TO CENTER OF SEC 9

1972 LEE CSM V2 PG 233 FOUND MON. BOX AT CORNER

1973 SHIMEALL CSM V3 PG 218 CALLS FOR MONUMENT BUT STATES NOTHING ABOUT 2707.48 TO CENTER SEC 10

1973 LEE CSM V3 PG 225 FOUND PIPE IN MON. BOX

1974 LEE MAP #209 FOUND PIPE IN MON. BOX. 2661.71 TO NE COR SEC 9,2591.66 TO CENTER SEC 9, 5267.69 TO W 1/4 COR SEC 9.

1986 LEUENBERGHER MAP #13194 SHOWS MONUMENT AT CORNER BUT STATES NOTHING ABOUT IT.

1986 LEE CSM V12 PG 377 LEE CONNECTED TO SURVEY

1989 LEE CSM V14 PG 173 FOUND CI

1989 LEE CSM V14 PG 178 FOUND CI

1989 LEE MAP #12152 FOUND CI

1990 BARNES G-13 FD PIN IN MON. BOX 2591.75 TO PIPE AT CENTER OF SEC 9. MON IS 1 NORTH OF E/W CENTER OF PVMT. REFERENCED SAME.

1994 KREBS MAP #9608 2591.69 TO CENTER SEC 9

1996 KREBS CSM VOL 20 PG 25 2654.37 TO SE COR SEC 9

1996 LEUENBERGER CSM VOL 19 PG 101 2707.10 TO CENTER SEC 10 & 5318.46 TO E 1/4 COR SEC 10.

1997 KREBS CMS VOL 20 PG 270 2707.10 TO CENTER SEC 10.

FOUND PIN IN MONUMENT BOX AND TIES OF RECORD.

- C) Was the corner restored through acceptance of (1) an obliterated evidence location, or, (2) a found perpetuated location? ACCEPTED FOUND LOCATION.
- D) Describe any material discrepancy between the location of the corner as restored or reestablished and the location of that corner as previously restored or reestablished by distance and direction. Show the discrepancy on the plan view drawing under (a), above. Show the distances between the corner as previously restored or reestablished and (1) the corner as restored or reestablished, and (2) to at least 4 of the witness monuments shown on the drawing in (a), above.

6-13(1)

(E) Was the corner reestablished through lost corner proportionate methods? If so, show the method, including the directions and distances to other public land survey corners used as evidence or used for proportioning the corner location.

I, Donald Barnes, hereby certify that the corner points as identified by the corner code index were, in a field survey, established, reestablished, monumented, re-monumented, recovered or restored as expressed below and in conformance with the regulations and rules as required in the current manual of survey instructions of the United States Department of Interior, Bureau of Land Management.

Donald Ramos October 291998

EMBOSS LAND SURVEYOR SEAL

COUNTY SURVEYOR FILING DATA

Date of computer entry\_\_\_\_

Date microfilmed \_\_\_\_\_

Number of included sheets \_ CORNER CODE

A-E 7.08 REQUIREMENT

G-13(1)