U.S.


## LAND **PUBLIC** SURVEY MONUMENT RECORD

For Public Land Survey Corners in:

WI ADMINISTRATIVE CODE A-E 7.08 REQUIREMENT

、 T. <del>2</del>N., R.//\_\_E

CORNER CODE INDEX

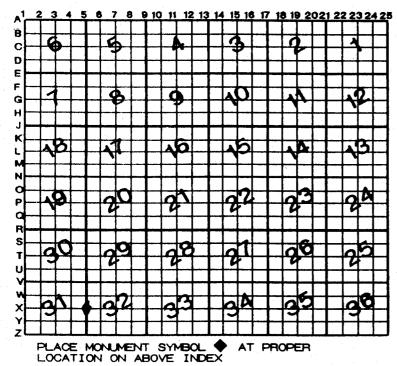

PLYNOUTH ROCK COUNTY WI

IF AVAILABLE ROCK COUNTY COORDINATES PERFERRED

North Elev. East

Hor. Datum \_\_\_\_\_ Vert. Datum

LATITUDE \_\_\_\_ ELLIPS. HT.

GPS (X) \_\_\_ TRAVERSE (X) \_

BASED ON THE FOLLOWING CONTROL:

**♦**CORNER MONUMENT

O WITNESS MONUMENT

LONGITUTE

BEARINGS ARE

(a)

						1	1
FIELD	BOOK	PAGE #			SHEET	OF	4
SHOW	A PLAN VIEW	DRAWING DEPICTING	THE CORNER	MONUMENT	AND SURRO	UNDING	
PHYSIC	CAL FEATURES,	INCLUDING THE EXC	AVATION ARE	A AND DEPTH	<b>1.</b>		
DI ANNIN	C . 70MING 00M	MAITTEE ADORTED THE A	BOVE FORM ON	10/0/1000			

## PL615

(B) Describe any record evidence, monument evidence, occupational evidence, testimonial evidence or any other material evidence you considered, and whether the monument was found or placed.

1833 HARRISON DEC. PG 32 NORTH BETWEEN SEC 31 & 32

QUARTER SEC COR NEAR N.E. EDGE OF PRAIRIE BUR OAK 24 586E 378.84'

4785 LEFT PRAIRIE & ENTER TIMBER

5280 COR TO SECS 29, 30, 31, 32 BUR OAK 24 N41E 51.48', BUR OAK 18 N22W 97.02', BUR OAK 10 578W

166.98', BUR DAK 10 576E 34.98'

1868 LOCKE PG 71 NORTH BETWEEN SECS 31 & 32 SEPT 12, 1868 VAR 7-10

2676.3 INTERSECTED 1/4 LINE 11.22' WEST OF 1/4 COR.
FOUND STUMP OF 8.T. AND OLD STAKE COR. IN N
AND S FENCE. VAR CORRECTED 6-55
CONTINUED NORTH FROM 1/4 COR WITH VAR 7-5

127.52 INTERSECTED NORTH BOUNDARY 18.48' EAST OF COR. VAR CORRECTED 7-29 SEPT 12 1868

1875 RUGER VOL 2 PG 193 FD STONE MON.

1993 KREBS MAP #09824 CUT STONE S1-02-41E 2676.36 TO SW COR SEC 32, N89-54-11E 5298.45 TO E 1/4 COR SEC 32, N89-54-11E 2636.11 TO CEN SEC 32, & N2-01-06W 2652.10 TO NW COR SEC 32

1999 TALARCZYK X-5 FD STONE MON. SHOWN ON PLAT BY
EDWARD RUGER DATED JUNE 14-15 1875 REFERENCED MON.
1999 TALARCZYK MAP #OBO48 FD 6" SQUARE STONE N1-26-10W
2651.97 TO NE COR SEC 31 & N89-49-47W TO W 1/4 COR SEC 31.

FD CUT L.S., REF. MONUMENTS, & CARSONITE POST

C) Was the corner restored through acceptance of (1) an obliterated evidence location, or, (2) a found perpetuated location?

ACCEPTED FOUND OUT LIMESTONE.

- D) Describe any material discrepancy between the location of the corner as restored or reestablished and the location of that corner as previously restored or reestablished by distance and direction. Show the discrepancy on the plan view drawing under (a), above. Show the distances between the corner as previously restored or reestablished and (1) the corner as restored or reestablished, and (2) to at least 4 of the witness monuments shown on the drawing in (a), above.
- (E) Was the corner reestablished through lost corner proportionate methods? If so, show the method, including the directions and distances to other public land survey corners used as evidence or used for proportioning the corner location.
- I, Donald Barnes, hereby certify that the corner location as identified by the corner code index was determined by me under my direction and control and that this U.S. Public Land Survey Monument Record is correct and complete to the best of my knowledge and belief.

Seul

SHEET 1 OF 1

Ond Baces
2/15/03

GORNER GODE X-5(1).

A.E. 7.08 REQUIREMENT