

U.S. PUBLIC LAND SURVEY MONUMENT RECORD

For Public Land Survey Corners In:
T. 2 N. R. 11 E. 4th P.M.
CORNER CODE INDEX

WI ADMINISTRATIVE CODE A-E 7.08 REQUIREMENT
REV 10/23/2004 USMONREC.DWG

	1	2	3	4	5	6	7	8	9	10	11	12	13	14	15	16	17	18	19	20	21	22	23	24	25
A																									
B																									
C	6																								
D																									
E																									
F																									
G	7																								
H																									
J																									
K	18																								
L																									
M																									
N																									
O																									
P	19																								
Q																									
R																									
S	30																								
T																									
U																									
V																									
W																									
X	31																								
Y																									
Z																									
	1	2	3	4	5	6	7	8	9	10	11	12	13	14	15	16	17	18	19	20	21	22	23	24	25

PLYMOUTH TWP
ROCK COUNTY WI

IF AVAILABLE
ROCK COUNTY COORDINATES PREFERRED

North _____ Elev. _____

East _____

Hor. Datum _____ Vert. Datum _____

LATITUDE _____ ELLIPS. HT. _____

LONGITUDE _____

NAD83(91) _____ NETWORK ADJ. YR _____

GPS (X) _____ TRAVERSE (X) _____

BASED ON THE FOLLOWING CONTROL:

ROCK COUNTY, FOOTVILLE, WI
Township/City/Village


Code: _____

Firm: (Surveyor) ROBERT HANSEN MSA-PROFESSIONAL SERV. T. 2 N. R. 11 E.
(Address) 2901 INTERNATIONAL LANE, SUITE 300
MADISON, WI. 53704-3133


Survey # _____ Coord. I.D. _____

Field Book: Vol. 101 Page 130

Corner Monumentation Found: FOUND 4" x 4" CUT STONE
MONUMENT IN CAST IRON BOX WITH
LID.

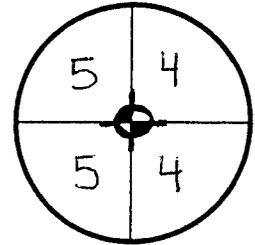

Location Sketch, showing corner identification name with references to at least four accessories, fence or occupational lines, centerlines of roads, and other site details for reference. If in disagreement with previously established corner, distances are shown between the two corners with references to the disputed corner from the accessories.

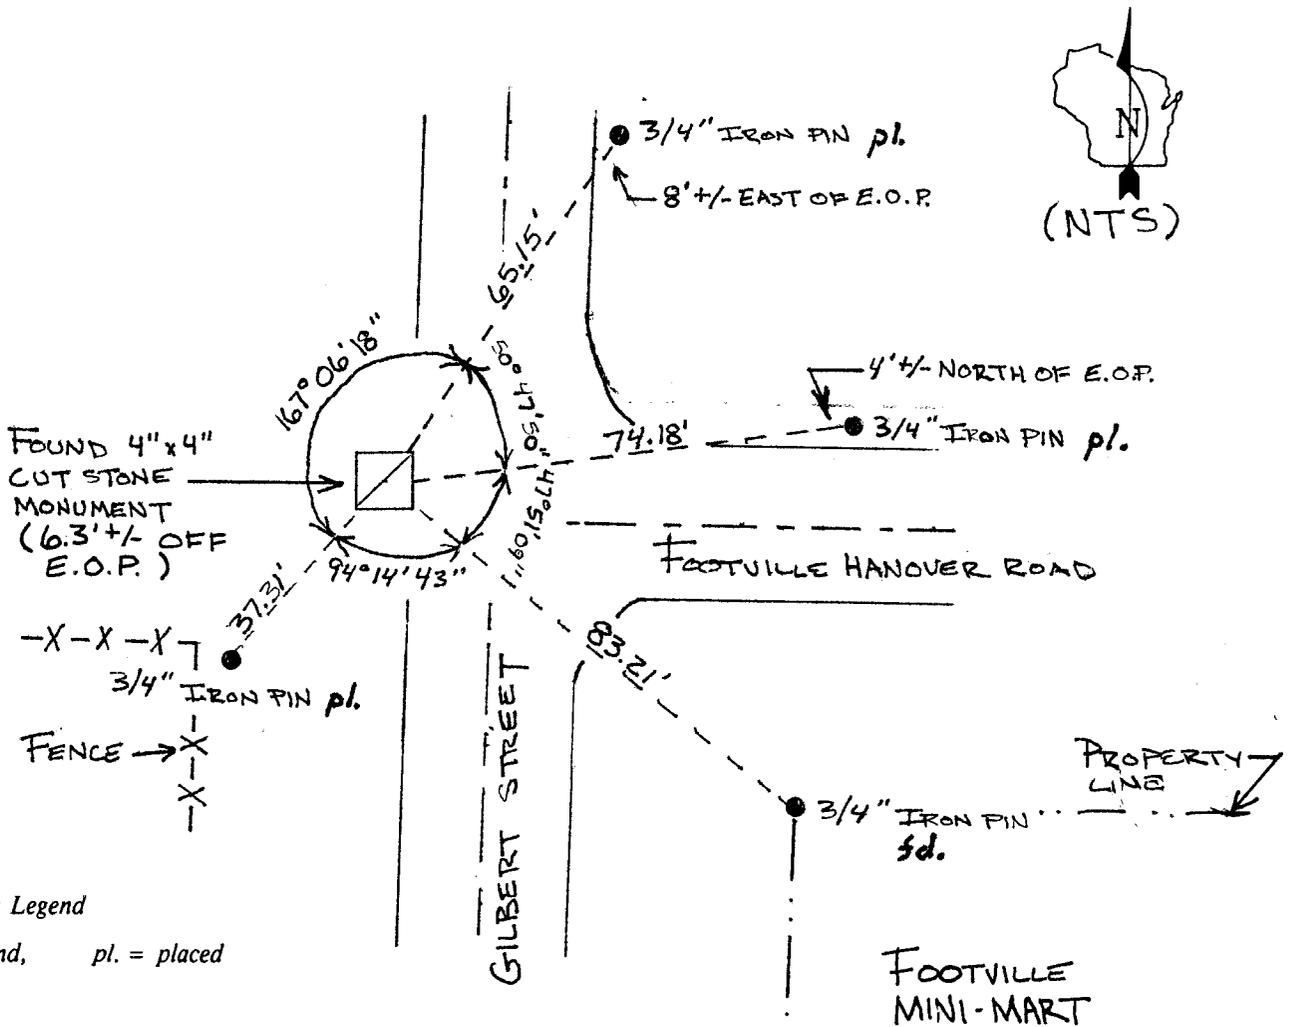

Monumentation Legend

fd. = found, pl. = placed

FOOTVILLE
MINI-MART

Basis For Monument Location

Including ~~substantive~~ record evidence, monument evidence, ~~comparative~~ evidence, or other material evidence; and whether the corner was found perpetuated, restored through obliterated evidence, reestablished by lost corner proportional methods, or relocated by witness testimony. If applicable, this basis also includes a description of traverse measurements to other field evidence considered including section or subdivisional section corners or lines of the U.S. Public Land Survey by description and/or diagram.

FOUND CUT STONE IN ROUND CAST IRON BOX IN
MAY 2001. MONUMENT WAS SLIGHTLY TIPPED. ACCEPTED,
USED MONUMENT THROUGHOUT CONSTRUCTION OF
WASTE WATER TREATMENT PLANT AND BUSINESS PARK.
MONUMENT IN SAME CONDITION AFTER COMPLETION
OF CONSTRUCTION, APRIL 2002.

Seal:

Robert J. Hachem
Registered Land Surveyor

R.L.S. No. S - 2432


Date: 5-15-02

Certifications:

I hereby certify that this U.S. Public Land Survey monument record is correct and complete to the best of my knowledge and belief, in accordance with Chapter A-E 7.08 of the Wisconsin Administrative Code.

If applicable, Section Control Data Sheets have been filed in the County Surveyor's office, showing final measurements by direction and distance between all traversed certified corners.

This information is referenced with Survey # _____, and dated _____, sheet(s) _____ of _____.

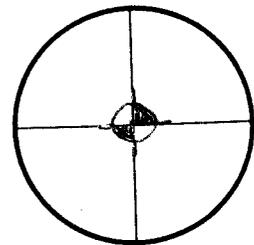

T. 2 N.-R. 11 E.
Code: C-009(2)

C-9(3)