

U.S. PUBLIC LAND SURVEY MONUMENT RECORD

For Public Land Survey Corners in:

WI ADMINISTRATIVE CODE A-E 7.08 REQUIREMENT

T. 4N., R. 11E 4th P.M.

CORNER CODE INDEX

1	2	3	4	5	6	7	8	9	10	11	12	13	14	15	16	17	18	19	20	21	22	23	24	25
A	6																							
B		5																						
C			4																					
D				3																				
E					2																			
F						1																		
G							8																	
H								9																
I									10															
J										11														
K											16													
L												15												
M													14											
N														13										
O															20									
P																21								
Q																	22							
R																		23						
S																			24					
T																				25				
U																					30			
V																						29		
W																						28		
X																							27	
Y																								26
Z																								25

Porter TWP
ROCK COUNTY, WI

IF AVAILABLE
ROCK COUNTY COORDINATES PREFERRED


North _____ Elev. _____
 East _____
 Hor. Datum _____ Vert. Datum _____
 LATITUDE _____ ELLIPS. HT. _____
 LONGITUDE _____
 ELLIPS. DATUM _____
 NAD83(91) _____ COUNTY _____ LIST _____
 GPS (X) _____ TRAVERSE (X) _____
 BASED ON THE FOLLOWING CONTROL:

PLACE MONUMENT SYMBOL \blacklozenge AT PROPER LOCATION ON ABOVE INDEX

\blacklozenge CORNER MONUMENT
(Set PK Nail)

WITNESS MONUMENT \odot 1" Pipe
D.B. = Don Barnes data, August 8, 1988

BEARINGS ARE BASED ON: Assumed Datum

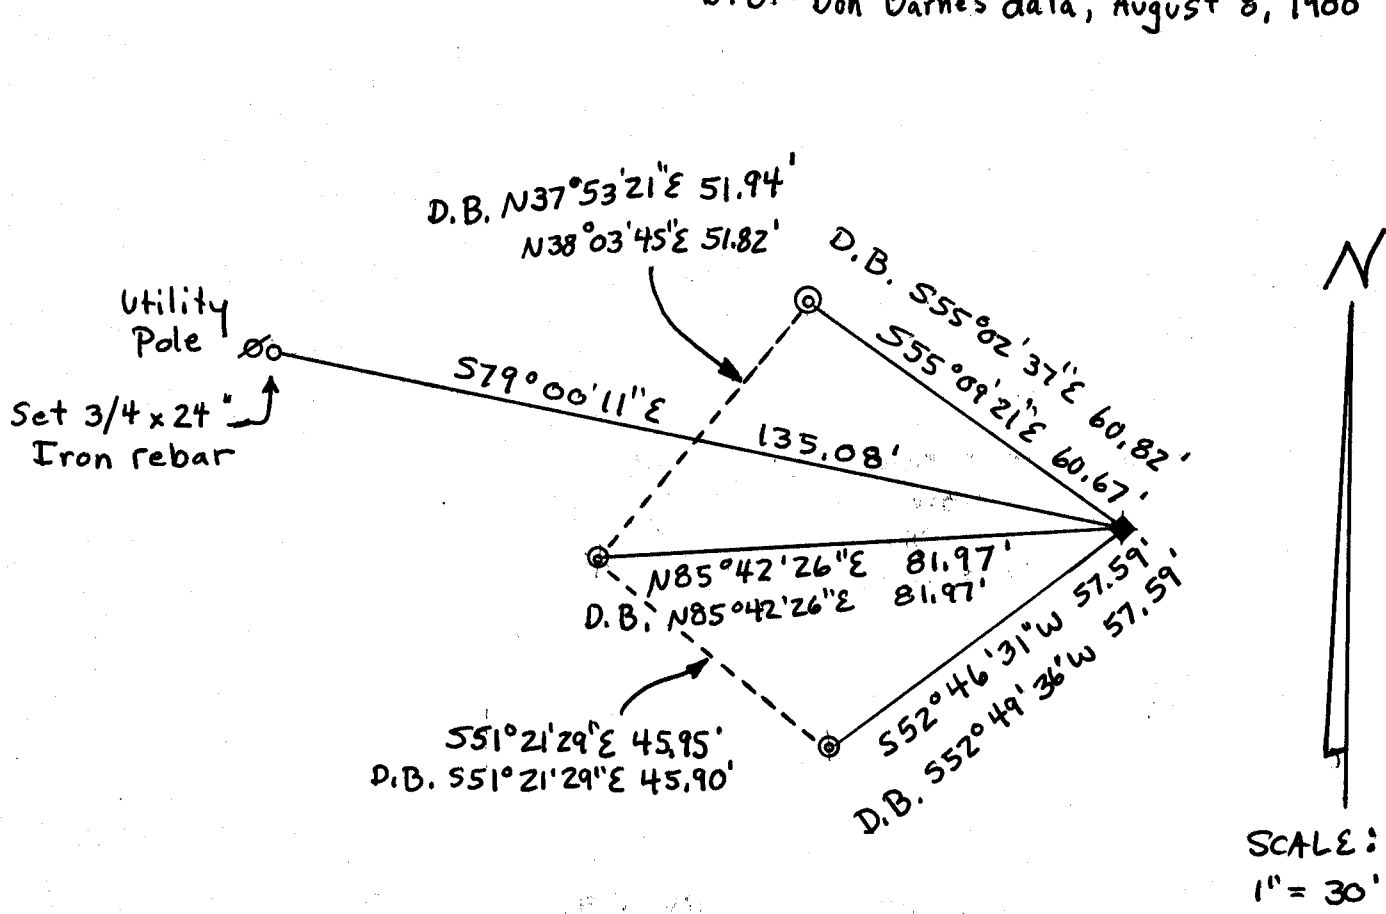

SCALE: 1" = 30'

FIELD BOOK _____ PAGE # _____ SHEET _____ OF _____

SHOW A PLAN VIEW DRAWING DEPICTING THE CORNER MONUMENT AND SURROUNDING PHYSICAL FEATURES, INCLUDING THE EXCAVATION AREA AND DEPTH.

PLANNING & ZONING COMMITTEE ADOPTED THE ABOVE FORM ON 12/2/1982

CORNER CODE A-7(1)

B) Describe any record evidence, monument evidence, occupational evidence, testimonial evidence or any other material evidence you considered, and whether the monument was found or placed.

Used data from 8-8-1988 tie sheet of Donald Barnes to set PK nail at Corner. Neither PK or PK stem as show previously were present.

C) Was the corner restored through acceptance of (1) an obliterated evidence location, or, (2) a found perpetuated location?

Used SW pipe and west pipe from Donald Barnes tie sheet of 8-8-1988 to set PK Nail, Didn't use North reference pipe as it didn't check Barnes-1988 measurements.

D) Describe any material discrepancy between the location of the Corner as restored or reestablished and the location of that corner as previously restored or reestablished by distance and direction. Show the discrepancy on the plan view drawing under (a), above. Show the distances between the corner as previously restored or reestablished and (1) the corner as restored or reestablished, and (2) to at least 4 of the witness monuments shown on the drawing in (a), above.

The discrepancies are noted on sketch.

E) Was the corner reestablished through lost corner proportionate methods? If so, show the method, including the directions and distances to other public land survey corners used as evidence or used for proportioning the corner location.

NO

I, Ronald J. Combs, hereby certify that the corner location as identified by the corner code index was determined by me under by direction and control and that this U.S. Public Land Survey Monument Record is correct and complete to the best of my knowledge and belief.



Number of included sheets _____

A-E 7.08 REQUIREMENT

CORNER CODE

A-7(1)