Paper weight-110# (minimum)

Black nonfading ink required

LAND U.S. SURVEY PUBLIC MONUMENT RECORD


For Public Land Survey Corners In:

WI ADMINISTRATIVE CODE A-E 7.08 REQUIREMENT

USMONREC.DWG REV 10/23/2004

T. 4 N. R. 11 E. 4th P.M.

CORNER CODE INDEX

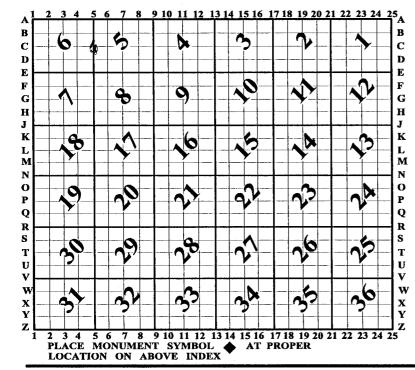

PORTER TWP **ROCK COUNTY WI**

IF AVAILABLE ROCK COUNTY COORDINATES PERFERRED

North Elev. East Hor. Datum _____ Vert. Datum **LATITUDE** ELLIPS. HT. LONGITUDE NAD83(91) NETWORK ADJ. YR GPS (X) ____ TRAVERSE (X) BASED ON THE FOLLOWING CONTROL:

CORNER MONUMENT

O WITNESS MONUMENT

BEARINGS ARE BASED ON:

(a)

FIELD BOOK PAGE # SHOW A PLAN VIEW DRAWING DEPICTING THE CORNER MONUMENT AND SURROUNDING PHYSICAL FEATURES, INCLUDING THE EXCAVATION AREA AND DEPTH. PLANNING & ZONING COMMITTEE ADOPTED THIS FORM ON 12/2/1982

CORNER CODE _

PO 515 EYA 6

(B) Describe any record evidence, monument evidence, occupational evidence, testimonial evidence or any other material evidence you considered, and whether the monument was found or placed.

1833 (NOV 4TH) HARRISON TAN R11E 4TH MER. NORTH BETWEEN

5&6

1980.0 LEFT PRAIRIE

2640.00 QUARTER SEC COR {RED 0 12 S23W

130.68'; RED OAK 14 532E 92.40' {RED

OAK 12; RED OAK 14 MARKED

2970.0 BROOK 13.2 @ E

5240.4 INT. N BDY 66.00' EAST OF POST {RED

OAK 12 540E 58.08'; RED OAK 16 S6W

72.6

LAND FOR THE $1^{\rm ST}$ 1980' ROLLING $1^{\rm ST}$ RUN OF MILE WOODLAND WITH TIMBER OF RED @ MOSTLY?

1893 BLEEDORN VOL 2 PG 473 FD STAKE & REMAINS OF ONE BT STUMP. 2588.52 TO NE COR SEC 6, VAR 5-10 2641.98 TO CENTER OF SEC 6

- 1933 SUNNY VOL 3 PG 227 DUG FD NOTHING AT E 1/4 COR.
 ACCEPTED E FENCE AS E. L. OF SEC 6, (WESTERLY ON E/W
 1/4 LINE) 1321.3 TO FD IRON ROD SET BY BLEEDORN IN
 1893 5' EAST OF FENCE TO NORTH LINE WITH FENCE TO
 WEST SURROUNDED IT WITH SMALL BOLDERS, 2642.3 TO 1
 1/2" PIPE AT CENTER OF SEC 6, 5203.8 TO 12X10X4
 LIMESTONE @ W 1/4 COR SEC 6. @ CENTER OF SEC 6 DUG
 UP BIG AREA COULD NOT FINED BLEEDORN'S COR. SET 1
 1/2 IRON PIPE 6' LONG SURROUNDED IT WITH SMALL
 BOLDERS AND LIME S. CENTER IS 17' EAST OF CENTER OF
 GRAVE RD.
- 1933 SUNNY #3567 DUG & FD NOTHING. MEASURED TO N/S FENCE LINE. FD IRON ROD SURROUND BY STONE AS SET BY BLEEDHORN @ THE S 1/16TH COR NE 1/4 SEC 6 WHICH IS 5' EAST OF THE N/S FENCE, 1321 FROM ROD TO N/S FENCE NEAR E 1/4 COR SEC 6 & 1321 FROM ROD TO PIPE @ CENTER OF SEC 6. @ CENTER OF SEC 6 SET 1 1/2X5' LONG WHICH IS 04' EAST OF CENTER GRAVEL RD, 150? SOUTH OF SOUTH END OF BRIDGE.
- 1988 BARNES C-5 SHOWS LIMITS OF EXCAVATION. PLACED CORNER AT SINGLE PROPORTIONATE DISTANCE.
 REFERENCED SAME. COR IS 14' WEST OF N/S FENCE & ON LINE WITH E/W FENCE TO THE EAST. PLACED POL MON.
 2589.40 TO NW COR SEC 5, 2628.85 TO SW COR SEC 5.
- 1988 BARNES VOL 6 PG 387 STATES NOTHING ABOUT MON. NO1-49-49E 2589.40 TO NE COR SEC 6, SO1-49-49W 2628.85 TO SE COR SEC 6, N89-07-14W 2649.19 TO PIPE NEAR CEN OF SEC 6, N89-04-52W 5203.51 TO W 1/4 COR SEC 6.
- 2002 COMBS #14500 FD PIPE NB9-40W 2197.87 TO SET PIN @ CENTER OF SEC 5, NB9-40W 4889.89 TO FD ALUM @ W 1/4 COR SEC 5.
- 2005 COMBS #15203 ALUM. USED FOR LINE @ W 1/4 COR 6.
- 2007 RESOP #515533 FD ALUM. N89-57-46W 2640.70 TO FD PIPE @ CENTER OF SEC 6, NO-56-23E 2589.22 TO FD ALUM @ NE COR SEC 6.
- 2007 RIESOP C-1 CALLS FOR ALUM MON. NB9-57-48W 5203.76 TO COMPUTED POSITION OF W 1/4 COR SEC 6

I USED MY 1988 OBSERVATIONS TO THE POLY MON.

SHEET 10F 3

CORNER CODE C-5(1)

Donald Caines 3/14/2009

PO515 E1/4CORSEC6

PO515 E1/4CORSEC6

C) Was the corner restored through acceptance of (1) an obliterated evidence location, or, (2) a found perpetuated location?

ACCEPTED POLY

D) Describe any material discrepancy between the location of the corner as restored or reestablished and the location of that corner as previously restored or reestablished by distance and direction. Show the discrepancy on the plan view drawing under (a), above. Show the distances between the corner as previously restored or reestablished and (1) the corner as restored or reestablished, and (2) to at least 4 of the witness monuments shown on the drawing in (a), above.

NONE

(E) Was the corner reestablished through lost corner proportionate methods? If so, show the method, including the directions and distances to other public land survey corners used as evidence or used for proportioning the corner location.

YES


I, **Donald Barnes**, hereby certify that the corner location as identified by the corner code index was determined by me under my direction and control and that this U.S. Public Land Survey Monument Regord is correct and complete to the best of my knowledge and belief.

SHEET 2 OF 3

Emboss 3/4/2009

CORNER CODE C-5(1)

A.E. 7.08 REQUIREMENT

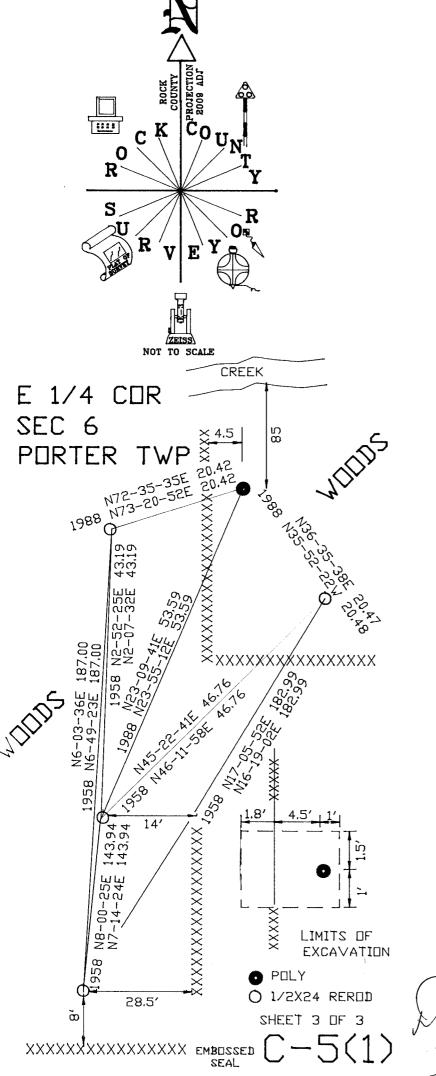

Donald Baines 3/16/2009