U.S.

(a)

Ż

BASED


LAND PUBLIC SURVEY MONUMENT RECORD

For Public Land Survey Corners in:

WI ADMINISTRATIVE CODE A-E 7.08 REQUIREMENT

T. \(\(\)

CORNER CODE INDEX

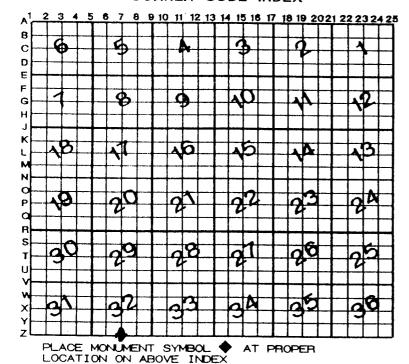

CLINTON ROCK COUNTY WI

IF AVAILABLE ROCK COUNTY COORDINATES PERFERRED

North /8/, 926.87 Elev.

East 2,274, 615.66 Hor. Datum NA027 Vert. Datum

LATITUDE ____ ELLIPS. HT.

LONGITUTE GPS (X) ___ TRAVERSE (X)

BASED ON THE FOLLOWING CONTROL:

CORNER MONUMENT ALUM

WITNESS MONUMENT 3320-00.22 WIDOT

> DATE! 2-26-93

514 588-48-ZZE SE3Z 588-48-11E 2651.81 32

NOTE ON PLAT: COORDINATES & BEARINGS ON THIS PLAT ARE ORIENTED TO THE WI COORDINATE SYSTEM UTILIZING A CONVERSION FACTOR THAT WAS COMPUTED TO MOST CLOSELY REPRESENT THAT USED BY THE STATE OF WISCONSIN AND THE STATE OF ILLINOIS. THE COMPUTATION INVOLVED DIVIDING GRID COORDINATES, AS **DETERMINED BY DISTRICT 1 SURVEY AT 3 SECTION** CORNERS (THE S ¼ COR OF SEC 32, THE S.E. COR OF SEC 32 AND THE S 1/4 COR OF SEC 33, ALL IN T1N R14E) & BY THE ILLINOIS GROUND COORDINATES SHOWN AT THE SAME CORNERS ON ILLINOIS HIGHWAY PLAN R-92-022-90, AND THEN AVERAGING THE RESULTS. ALL PLAT DISTANCES AND GROUND LENGTH, FROM COMPUTATIONS UTILIZING WDOT COORDINATES AND MAY BE CONVERTED TO GRID LENGTH BY MULTIPLYING THE GRID FACTOR PROVIDED ON THE DETAIL SHEET (5) [SHEET (5) WAS NOT SENT TO THE COUNTY)

.PAGE #

FIELD BOOK SHOW A PLAN VIEW DRAWING DEPICTING THE CORNER MONUMENT AND SURROUNDING PHYSICAL FEATURES, INCLUDING THE EXCAVATION AREA AND DEPTH.

PLANNING & ZONING COMMITTEE ADOPTED THE ABOVE FORM ON 12/2/1982