equired


## U.S. PUBLIC LAND SURVEY MONUMENT RECORD

For Public Land Survey Corners in:

WI ADMINISTRATIVE CODE A-E 7.08 REQUIREMENT

T. \_/N., R. \_/4\_E

CORNER CODE INDEX

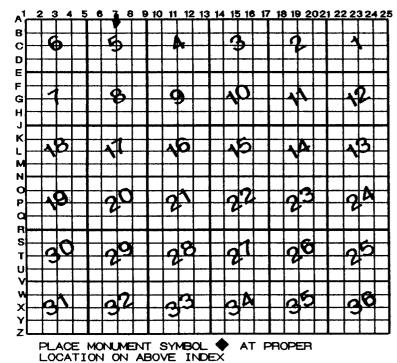

CLIN	TWI	
ROCK	COUNTY	WI

IF AVAILABLE

North Elev	
East	
Hor. Datum Vert. Datum	
LATITUDEELLIPS. H	Т.
LONGITUTE	
GPS (X) TRAVERSE (X)	
BASED ON THE FOLLOWING CONTROL:	

**CORNER MONUMENT** 

O WITNESS MONUMENT

BEARINGS ARE BASED ON:

(a)

OBSERVATION Sheet		OF	2
FIELD BOOKPAGE #	SHEET	OF	
SHOW A PLAN VIEW DRAWING DEPICTING THE CORNER MONUMENT AND	SURRO	UNDING	
PHYSICAL FEATURES, INCLUDING THE EXCAVATION AREA AND DEPTH.			
STANDARD & TOURS CONTROL TO A BOARD THE ABOUT CONTROL AS A LABOR.			

CL504

- (B)Describe any record evidence, monument evidence, occupational evidence, testimonial evidence or any other material evidence you considered, and whether the monument was found or placed.
- 1869 LEE VOL 1 PG 347 FD REMAINS OF OLD STAKE. SET WHITE OAK STAKE SURROUNDED BY 4 HH. 2663.1 VAR 5 TO NE COR SEC 5 & 2995.08 TO CENTER OF SEC 5.
- 1873 RUGER VOL 2 PG 119 FD OLD STAKE SURROUNDED BY 4 HH STONES. SET NEW STAKE IN PLACE OF OLD ONE. ESTABLISHED N/S 1/4 LINE SEC 32 MANY POINTS ALONG THE LINE & CALLS TO PHYSICAL FEATURES.
- 1874 RUGER VOL 2 PG 125 FD COR. ESTABLISHED BY SELF
- 1878 RUGER VOL 2 PG 258 FD COR. AS ESTABLISHED BY SELF IN FORMER SURVEY. USED TO SUBDIVIDE SEC 5.
- 1930 SUNNY VOL 3 PG 181 FOUND STAKE SURROUNDED BY 4 LIME STONES 2' DEEP. REFERENCED SAME. \*=COPIED FROM PG 213 BELOIT RECORDS. 12/15/75 BARNES. \* SURVEY BY SUNNY OCT 12,13 1932 RESET MON WITH 1"X2' PIPE USING ABOVE REFERENCES & THE SE REFERENCE. CENTER OF CONCRETE PAVEMENT IS 2.7' WEST OF MONUMENT.
- 1970 BATTERMAN VOL 4 PG 477 FOUND 1" PIPE 2.70 EAST OF CENTER OF PAVEMENT AS CALLED FOR IN VOL 3 PG 213. REFERENCED SAME.
- 1978 SCHOEDER CSM 8 PG 242 2646.00 TO CENTER OF SEC 32.
- 19?? WIDOT A-7 TIES WITH NO DESCRIPTION OF MON.
- 1980 BARNES VOL 6 PG 47 CALLS FOR N89-34-54W 2648.70 TO NW COR SEC 5 & S89-39-09E 2660.39 TO NE COR SEC 5.
- 1980 BARNES VOL 6 PG 69 SET ALUM. MON.
- 1981 BARNES REMONUMENTATION. N89-34-54W 2648.70 TO NW COR SEC 5, S89-39-09E 2660.39 TO NE COR SEC 5, & S0-08-20E 5650.11 TO S 1/4 COR SEC 5.
- 1982 BARNES REMONUMENTATION. N88-33W 2648.7 TO NW COR SEC 5, S88-38E 2660.4 TO NE COR SEC 5, & N0-38-12E 2646.22 TO CENTER OF SEC 32.
- 1982 BARNES A-7(1) 10" DEEP FOUND BOTTOM OF ALUM. MON. SET CI MON ON TOP.

## FOUND C.I. MON. & REFERENCE PINS & PIPES.

C) Was the corner restored through acceptance of (1) an obliterated evidence location, or, (2) a found perpetuated location?

## ACCEPTED FOUND PERPETUATED LOCATION.

- D) Describe any material discrepancy between the location of the corner as restored or reestablished and the location of that corner as previously restored or reestablished by distance and direction. Show the discrepancy on the plan view drawing under (a), above. Show the distances between the corner as previously restored or reestablished and (1) the corner as restored or reestablished, and (2) to at least 4 of the witness monuments shown on the drawing in (a), above.
- (E) Was the corner reestablished through lost corner proportionate methods? If so, show the method, including the directions and distances to other public land survey corners used as evidence or used for proportioning the corner location.
- I, Donald Barnes, hereby certify that the corner location as identified by the corner code index was determined by me under my direction and control and that this U.S. Public Land Survey Monument Record

