PUBLIC LAND U.S. MONUMENT RECORD


SURVEY

For Public Land Survey Corners in:

WI ADMINISTRATIVE CODE A-E 7.08 REQUIREMENT

T. 4N., R. /2E

CORNER CODE INDEX

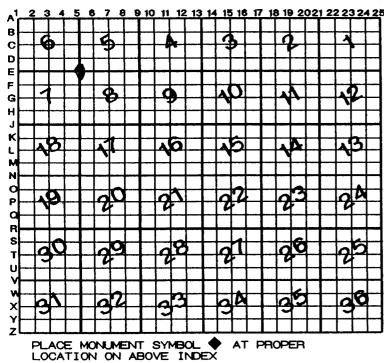

FULT	ON	TWI
•	COUNTY	WI

IF AVAILABLE ROCK COUNTY COORDINATES PERFERRED

North _____ Elev. Hor. Datum _____ Vert. Datum _ LATITUDE __ ELLIPS. HT. LONGITUTE GPS (X) ____ TRAVERSE (X) ___ BASED ON THE FOLLOWING CONTROL:

♦CORNER MONUMENT

O WITNESS MONUMENT

BEARINGS ARE BASED ON:

(a)

ARG	SERV	ATC	کمہ	54	EET	-5
()(2)		* \	-1-		_ (_

SHEET \bot OF 2FIELD BOOK_ _PAGE #_ SHOW A PLAN VIEW DRAWING DEPICTING THE CORNER MONUMENT AND SURROUNDING PHYSICAL FEATURES, INCLUDING THE EXCAVATION AREA AND DEPTH. PLANNING & ZONING COMMITTEE ADOPTED THE ABOVE FORM ON 12/2/1982

corner code <u>\(\xi - 5\)</u>

FU523

- (B)Describe any record evidence, monument evidence, occupational evidence, testimonial evidence or any other material evidence you considered, and whether the monument was found or placed.
- 1871 RUGER VOL 2 PG 79. FOUND OLD STAKE & HH STONES, ALSO FOUND STUMPS OF S.W., SE BTS & WHERE STUMPS OF N.E. BT HAD BEEN DUG OUT. DROVE STAKE DEEP & PUT ON TOP OF IT RED HH STONE 12X9X8 SURROUNDED 4 HH STONES. VAR 6-35 2671.68 TO S 1/4 COR SEC 6.
- 1968 BATTERMAN JR. VOL 4 PG 357 SET 1" PIPE IN BLACK TOP & REFERENCED SAME. N/S 304,722.22; E/W 2,238,254.18 (WP&L).
- 1974 WP&L VOL 6 PG 303 N88-34-35E 2730.35 TO S 1/4 COR SEC 5, S88-52-02W 2678.34 TO S 1/4 COR SEC 6, N1-13-34W 2661.73 TO W 1/4 COR SEC 5, S1-57-41E 2646.08 TO W 1/4 COR SEC 8, & N0-13-34E 1330.56 TO W 1/16TH COR OF SW 1/4 SEC 5.
- 1978 SANDNESS VOL 5 PG 448 N/S 304,722.22; E/W 2,238,254.18.
- 1991 BARNES E-5 FOUND PK & REFERENCED SAME. FOUND 1" PIPE 0.4' DEEP. DID NOT ACCEPT NOR REJECT FOUND MONUMENT. CORNER REFERENCED FOR ROAD CONSTRUCTION PROJECT.

FOUND 1" PIPE 0.4' DEEP.

C) Was the corner restored through acceptance of (1) an obliterated evidence location, or, (2) a found perpetuated location?

ACCEPTED FOUND PERPETUATED LOCATION.

- D) Describe any material discrepancy between the location of the corner as restored or reestablished and the location of that corner as previously restored or reestablished by distance and direction. Show the discrepancy on the plan view drawing under (a), above. Show the distances between the corner as previously restored or reestablished and (1) the corner as restored or reestablished, and (2) to at least 4 of the witness monuments shown on the drawing in (a), above.
- (E) Was the corner reestablished through lost corner proportionate methods? If so, show the method, including the directions and distances to other public land survey corners used as evidence or used for proportioning the corner location.

I, Donald Barnes, hereby certify that the corner location as identified by the corner code index was determined by me under my direction and control and that this U.S. Public Land Survey Monument Record is correct and complete to the best of my knowledge and belief.

emboss

Nay 6,1999

Number of included sheets 1

