

U.S. PUBLIC LAND SURVEY MONUMENT RECORD

For Public Land Survey Corners in:

WI ADMINISTRATIVE CODE A-E 7.08 REQUIREMENT

T. 4N., R. 12E

CORNER CODE INDEX

1	2	3	4	5	6	7	8	9	10	11	12	13	14	15	16	17	18	19	20	21	22	23	24	25
A																								
B	6													3							2			1
C																								
D																								
E	◆																							
F																								
G	7													10						11			12	
H																								
I																								
J																								
K																								
L	18													15						14			13	
M																								
N																								
O																								
P	19													22						23			24	
Q																								
R																								
S																								
T	30													27						26			25	
U																								
V																								
W																								
X	31													34						35			36	
Y																								
Z																								

FULTON TWP
ROCK COUNTY WI

IF AVAILABLE
ROCK COUNTY COORDINATES PREFERRED

North _____ Elev. _____

East _____

Hor. Datum _____ Vert. Datum _____

LATITUDE _____ ELLIPS. HT. _____

LONGITUDE _____

GPS (X) _____ TRAVERSE (X) _____

BASED ON THE FOLLOWING CONTROL:

PLACE MONUMENT SYMBOL ◆ AT PROPER LOCATION ON ABOVE INDEX

◆ CORNER MONUMENT ○ WITNESS MONUMENT

BEARINGS ARE BASED ON:

OBSERVATION SHEET

FIELD BOOK _____ PAGE # _____

SHEET 1 OF 2

SHOW A PLAN VIEW DRAWING DEPICTING THE CORNER MONUMENT AND SURROUNDING PHYSICAL FEATURES, INCLUDING THE EXCAVATION AREA AND DEPTH.

PLANNING & ZONING COMMITTEE ADOPTED THE ABOVE FORM ON 12/2/1982

CORNER CODE E 3(1)

FU522

(F) Describe any record evidence, monument evidence, occupational evidence, testimonial evidence or any other material evidence you considered, and whether the monument was found or placed.

- 1865 LOCKE VOL 1 PG 226 FOUND STUMPS OF B.T. & OLD STAKE. 2668.12 TO CENTER OF SEC 6 & 5315.8 TO N 1/4 COR SEC 6.
- 1871 RUGER VOL 2 PG 79 FOUND OLD STAKE & WHERE STUMPS OF B.T. HAD BEEN DUG UP. DROVE STAKE DEEP & PUT ON TOP OF IT LIMESTONE 22X6X4 SURROUNDED IT WITH 4 IRL. VAR 7-25 2672.34 TO SW COR SEC 6, VAR 6-35 2671.68 TO SE COR SEC 6, & VAR 7-28 ALONG N/S CENTER LINE OF SEC 7.
- 1968 BATTERMAN VOL 4 PG 357 SET 1" PIPE IN BLACK TOP. REFERENCED SAME. CALLS WPL 1974 COORDINATES OF 304,669.27; 2,235,576.36
- 1978 BARNES VOL 5 PG 483 FD PK & 0.1' DEEP FD 1" PIPE 0.11' NORTH OF PK. REPLACED 1" PIPE WITH ALUM. MON. REFERENCED SAME.
- 1983 BARNES VOL 6 PG 303 CALLS FOR WPL COORDINATES OF 304,669.27; 2,235,576.36 & WPL N88-52-02E 2678.34 TO SE COR SEC 6.
- 1991 BARNES E-3 FD ALUM. MON. 3' NORTH OF CENTER OF DVMT REFERENCED SAME.

FD ALUM. MON. 0.7' DEEP WITH TOP BROKE OFF.

(C) Was the corner restored through acceptance of (1) an obliterated evidence location, or, (2) a found perpetuated location?

ACCEPTED FOUND PERPETUATED LOCATION.

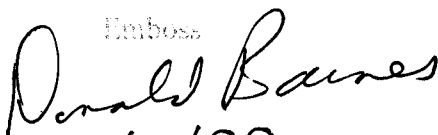
(D) Describe any material discrepancy between the location of the corner as restored or reestablished and the location of that corner as previously restored or reestablished by distance and direction. Show the discrepancy on the plan view drawing under (a). above. Show the distances between the corner as previously restored or reestablished and (1) the corner as restored or reestablished, and (2) to at least 4 of the witness monuments shown on the drawing in (a). above.

(E) Was the corner reestablished through lost corner proportionate methods? If so, show the method, including the directions and distances to other public land survey corners used as evidence or used for proportioning the corner location.

I, Donald Barnes, hereby certify that the corner location as identified by the corner code index was determined by me under my direction and control and that this U.S. Public Land Survey Monument Record is correct and complete to the best of my knowledge and belief.

Seal

Number of included sheets 1

Emboss

 11/4/99

CORNER CODE **E-3(1)**

A-E 7.08 REQUIREMENT

