

U.S. PUBLIC LAND SURVEY MONUMENT RECORD


For Public Land Survey Corners in the
T. 4 N., R. 13 E.

CORNER CODE INDEX

	1	2	3	4	5	6	7	8	9	10	11	12	13	14	15	16	17	18	19	20	21	22	23	24	25
A																									
B																									
C	6																								
D		5																							
E			4																						
F				3																					
G					2																				
H																									
I																									
J	7																								
K		6																							
L			5																						
M				4																					
N					3																				
O						2																			
P							1																		
Q																									
R																									
S																									
T	30																								
U		29																							
V			28																						
W				27																					
X					26																				
Y						25																			
Z							24																		
								23																	
									22																
										21															
PLACE MONUMENT SYMBOL (◆) AT PROPER LOCATION ON ABOVE INDEX

EXAMPLE

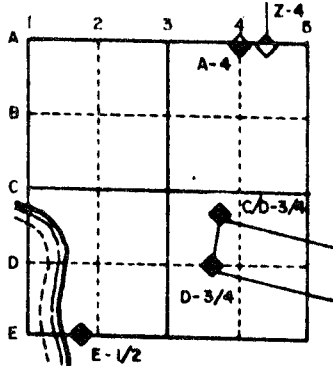

MILTON TWP
ROCK COUNTY WI

IF AVAILABLE
STATE PLANE COORDINATES

North (Y) _____ Eleve. (Z) _____
 East (X) _____ Zone _____
 Hor. Datum _____ Vert. Datum _____

(a) ◆ CORNER MONUMENT

○ WITNESS MONUMENT

BEARINGS ARE BASED ON:

FIELD BOOK _____ PAGE # _____

SHOW A PLAN VIEW DRAWING DEPICTING THE CORNER MONUMENT AND SURROUNDING PHYSICAL FEATURES, INCLUDING THE EXCAVATION AREA AND DEPTH. THE CORNER MONUMENT SHALL HAVE THE FOLLOWING CHARACTERISTICS: 1) HAVE AT LEAST TWO PREDETERMINED BREAK-OFF POINTS. 2) IF BROKEN, LEAVE A PERMANENTLY MAGNETIZED REMNANT AT THE ORIGINAL POINT. 3) MUST BE EXTENDABLE. 4) THE CAP IS INSCRIBED: ROCK COUNTY SURVEY MONUMENT - PENALTY FOR DISTURBING MARKER. 5) OR AN EXISTING CUT LIMESTONE. AN IRON PIPE 1 1/2" x 4'0" (MINIMUM) MAY BE USED IN AREAS WHERE GROUND WATER IS WITHIN ONE FOOT OF THE SURFACE. IF THE CORNER IS OCCUPIED BY AN IMPROVEMENT (MANHOLE, BURIED CABLE, ETC.) ANY DURABLE, DISTINCT MONUMENT MAY BE USED. CORNERS SHALL BE REFERENCED WITH AT LEAST 4 DURABLE WITNESS MONUMENTS. WITNESS MONUMENTS SHALL BE MADE OF CONCRETE, NATURAL STONE, IRON OR OTHER EQUALLY DURABLE MATERIAL, EXCEPT WOOD. DESCRIBE THE CORNER AND THE WITNESS MONUMENTS.

MICROFILMED

CORNER CODE:
J 17

(b.) Describe any record evidence, monument evidence, occupational evidence, testimonial evidence or any other material evidence you considered, and whether the monument was found or placed.

1871 RUGER REMONUMENTATION NOTES NORTH ON WEST LINE OF NW 1/4 OF SEC 14 ON A VAR 6-00 AT 2649.40 INTERSECTED NORTH BOUNDARY LINE 10 LKS WEST OF CORNER. FOUND STUMPS OF BEARING TREES & ESTABLISHED CORNER FROM THEM. CORRECTED VAR 5-57. 2629.44 TO N 1/4 COR SECT 15 & 2612.28 TO N 1/4 CORNER OF SEC 14.

1939 SUNNY VOL 3 PG 409 FOUND STONE MON. SHOWS DISTANCE OF 2683.2 TO SOUTH QUARTER CORNER OF SECTION 11 AND 2683.2 TO SOUTH QUARTER CORNER OF SECTION 10.

19?? BATTERMAN VOL 5 PG 82 SET C.I. MON FROM SUNNY SURVEY. SHOWS 2688.54 TO N 1/4 COR SEC 14 & 2651.10 TO W 1/4 COR SECTION 14.

DUG & FOUND BOTTOM 24" OF CUT LIMESTONE 3.3' DEEP. PLACED 3 MAGNETS AND BENT REEROD HORIZONTALLY NEXT TO STONE.

(c.) Was the corner restored through acceptance of (1) an obliterated evidence location, or, (2) a found perpetuated location?


ACCEPTED FOUND CUT LIMESTONE.

(d.) Describe any material discrepancy between the location of the corner as restored or reestablished and the location of that corner as previously restored or reestablished by distance and direction. Show the discrepancy on the plan view drawing under (a), above. Show the distances between the corner as previously restored or reestablished and (1) the corner as restored or reestablished, and (2) to at least 4 of the witness monuments shown on the drawing in (a), above.

SEE "C" AND DIAGRAM.

(e.) Was the corner reestablished through lost corner proportionate methods? If so, show the method, including the directions and distances to other public land survey corners used as evidence or used for proportioning in determining the corner location.

I, Donald Barnes, hereby certify that the corner points as identified by the corner code index were, in a field survey on Aug 1 1989, established, re-established, monumented, re-monumented, recovered or restored as expressed below and in conformance with the regulations and rules as required in the current manual of survey instructions of the United States Department of Interior, Bureau of Land Management.

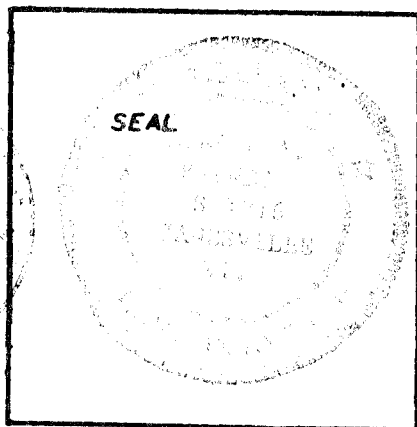

COUNTY SURVEYOR FILING DATA

Date of Computer Entry _____

Date Received _____

Date Microfilmed _____

Treasurer's Receipt No. _____

Number of Included Sheets 2

CORNER CODE 517

AFFIX YOUR LAND SURVEYOR SEAL.

U.S. PUBLIC LAND SURVEY MONUMENT RECORD


For Public Land Survey Corners in the
T. 4 N., R. 13 E.

CORNER CODE INDEX

	1	2	3	4	5	6	7	8	9	10	11	12	13	14	15	16	17	18	19	20	21	22	23	24	25
A																									
B																									
C	6																								
D		5																							
E			4																						
F				3																					
G					2																				
H																									
I	7																								
J		8																							
K			9																						
L				10																					
M					11																				
N						12																			
O							13																		
P								14																	
Q									15																
R										16															
S											17														
T												18													
U													19												
V														20											
W															21										
X																22									
Y																	23								
Z																		24							
																			25						
																				26					
																					27				
																						28			
																							29		
																								30	
																									31
																									32
																									33
																									34
																									35
																									36

PLACE MONUMENT SYMBOL (◆) AT PROPER LOCATION ON ABOVE INDEX

EXAMPLE

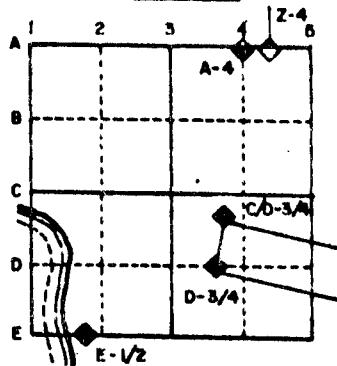

MILTON TWP
ROCK COUNTY WI

IF AVAILABLE STATE PLANE COORDINATES

North (Y) _____ Eleve. (Z) _____
 East (X) _____ Zone _____
 Hor. Datum _____ Vert. Datum _____

(c.) ◆ CORNER MONUMENT ○ WITNESS MONUMENT

BEARINGS ARE BASED ON: 1983 Township PROTECT

FD CAST IRON MONUMENT
& 3.3' DEEP THE BOTTOM
HALF OF CUT LIMESTONE MON.
PLACED 3 MAGNETS & BENT REROD
HORIZONTALLY BY THE STONE.

FD D.O.T. DISK
IN CONCRETE

C.I. S44-20-25E 17.47
L.S. S54-13-26E 19.50

FD D.O.T. DISK
IN CONCRETE

N16-57-27E 23.73

FD D.O.T. DISK
IN CONCRETE

C.I. N61-54-52E 21.68
L.S. N63-34-32E 25.40

N72-53-33E 147.25

C.I. S66-31-43W 140.12
L.S. S66-20-44W 136.37

N73-09-47E 3.77

S7-30-40W 155.59

L.S. N46-24-44W 144.38
C.I. N47-41-52W 146.28

N55-16-28W 154.91

S.T.H. 26

WOODS

FD D.O.T. DISK
IN CONCRETE

FIELD



FIELD BOOK 2
P 6 56, 63



MICROFILMED

SHEET 2 OF 3

CORNER CODE: 517

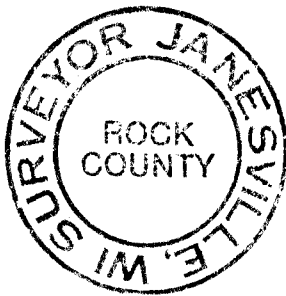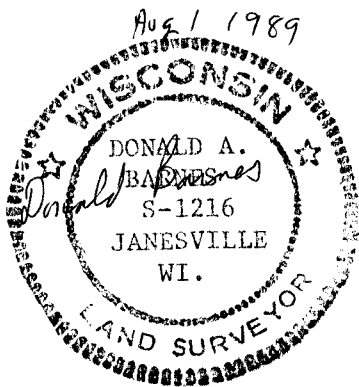


SEC 10

SEC 11

SEC 15

SEC 14

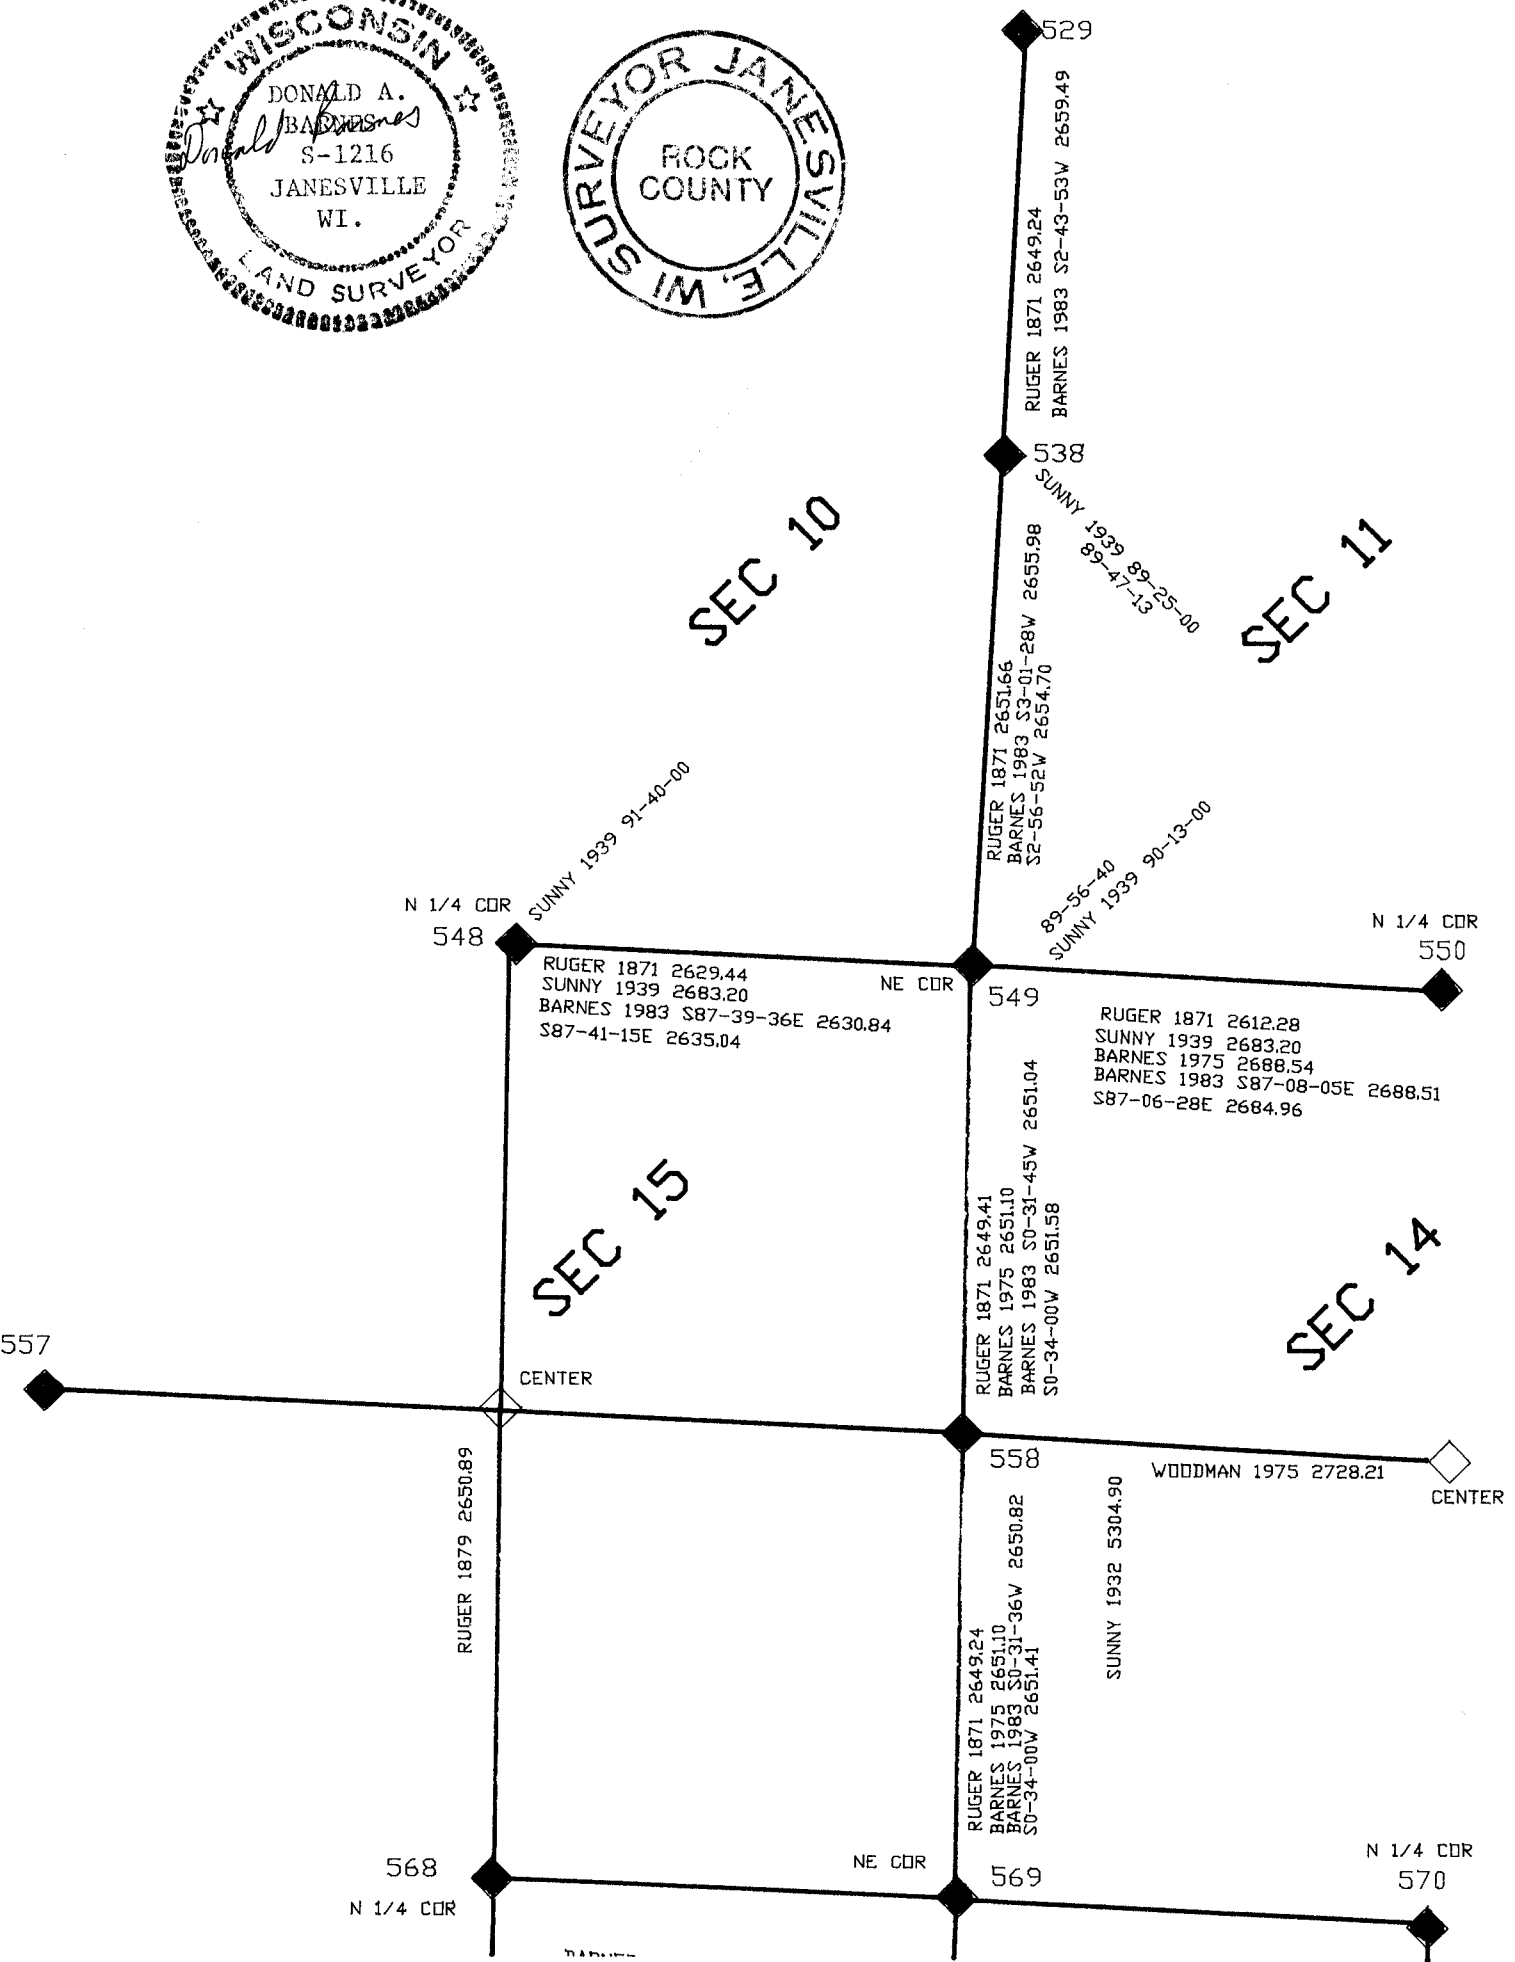

517