LAND


Black nor required SURVEY

MONUMENT RECORD

WI ADMINISTRATIVE CODE A-E 7.08 REQUIREMENT

For Public Land Survey Corners in: T. 4N., R. 13 E

CORNER CODE INDEX

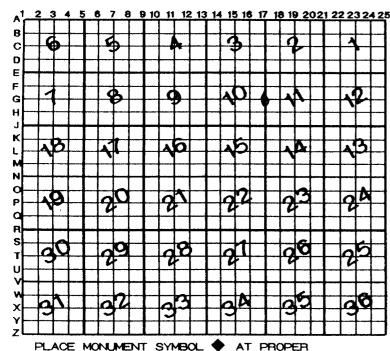

MIL	TON	TWI
ROCK	COUNTY	wı

IF AVAILABLE ROCK COUNTY COORDINATES PERFERRED

North 320,2461,48 Elev.

East 5/6,741.08

Hor. Datum _____ Vert. Datum

_____ELLIPS. HT.

LONGITUTE ____

GPS (X) ___ TRAVERSE (X) ___

BASED ON THE FOLLOWING CONTROL:

CORNER MONUMENT

O WITNESS MONUMENT

ö

(a)

SHEET . FIELD BOOK _PAGE # SHOW A PLAN VIEW DRAWING DEPICTING THE CORNER MONUMENT AND SURROUNDING PHYSICAL FEATURES, INCLUDING THE EXCAVATION AREA AND DEPTH. PLANNING & ZONING COMMITTEE ADOPTED THE ABOVE FORM ON 12/2/1982

MI538

(B)Describe any record evidence, monument evidence, occupational evidence, testimonial evidence or any other material evidence you considered, and whether the monument was found or placed.

- 1836 BURNHAM NORTH BETWEEN SECTIONS 10 & 11
 - 991.98 BUR OAK 10 IN DIA
 - 1995.84 YELLOW OAK 10 IN DIA
 - 2640 SET ¼ SEC POST W. OAK 14 N38W 73.92', BUR OAK 14 S87 ½E 39.6,
 - 4290 WILD MEADOW SPRING OF PURE WATER 66' EAST OF LINE C N.W. STREAM 9.9' WIDE C N.W.
 - 5280 SET POST COR TO 2,3,10,11 BUR OAK 10 NW. 1014.42', NO OTHER BEARING. FIRST RATE BUR OAK OPENINGS, GENTLY ROLLING.
- 1871 RUGER REMONUMENTATION FIELD NOTES

NORTH ON WEST LINE OF SW 1/4 SEC 11 ON A VAR 3-30 PG 307

2651.66 INT. ¼ LINE 13.2' WEST OF ¼ COR. FD OLD STAKE AT COR. ALSO FD STUMP OF S.E. BT & WHERE STUMP OF N.W. B.T. HAD BEEN DUG UP. COR VAR 3-13.

NORTH ON WEST LINE OF N.W. 4 OF SEC 11 ON A VAR 3-30. OFFSET 38.94'

- 2649.24 INT. NORTH BOUNDARY LINE 48.18' EAST OF COR. CORRECTED VAR 3-42
- 1892 BLEEDHORN VOL 2 PG 471 FD MON. VAR 2-05 2673.66 TO CENTER OF SEC 11
- 1939 SUNNY VOL 3 PG 409 FD STONE MON. SEE PAGE 452. 2634.2 TO CENTER OF SEC 10 & N88-28E 2689.7 TO CENTER OF SEC 11. FENCE IS 9.5' EAST OF LINE.
- 1939 SUNNY VOL 3 PG 452 FD 6X6 STONE MON. SET 1 ½ X 21" CAPPED PIPE ON TOP. REFERENCED SAME.
- 1939 SUNNY FILE C ANGLE 89-25-00 @ E 1/4 COR SEC 10 FROM CENTER OF SEC 11 TO SE COR SEC 10.
- 1964 BATTERMAN VOL 4 PG 104 FD 6X6 CUT STONE WITH TOP BROKE OFF. SET 1" PIPE & REFERENCED SAME. 66.18' TO R.R. @ CENTER OF PVMT. THE NEW RD WILL BE NORTH OF OLD RD.
- 1969 BATTERMAN VOL 4 PG 389 SET 1" PIPE AT W ¼ COR FROM REFERENCES. SEE PG 104. S86-45-15E 5349.36' TO E ¼ COR SEC 11. BEARINGS ARE TRUE BEARINGS.
- 1982 BARNES VOL 6 PG 252 FD ALUM. MON. BEARINGS AS SHOWN ARE BASED ON TRUE NORTH. REFERENCED SAME. FB. #13 PG 46
- 1982 BARNES VOL 6 PG 263 SHOWS TRAVERSE.
- 1982 BARNES VOL 6 PG 266 S86-50-16E 5349.27 TO E ¼ COR SEC 11 & 1974 NORTHRUP 2682.00 TO CENTER OF SEC 11.
- 1983 BARNES REMONUMENTATION N2-43-53E 2659.49 TO NE COR SEC 10, S2-56-52W 2654.70 TO SE COR SEC 10 (CHANGED IN 1989).
- 1989 BARNES L-17 & J-17 ANGLE @ E ¼ COR SEC 10 FROM CENTER OF SEC 11 TO SE COR SEC 10 IS 89-47-13 (1939 SUNNY 89-25-00).

FOUND 1" PIPE IN WEST EDGE OF WESTERN TIRE PATH. ESTABLISHED COUNTY COORDINATES FROM WPL GPS POINT & REFERENCED SAME. READJUSTED MILTON TWP. S86-49-31E 2681.32 TO CENTER OF SEC 11, S86-52-13E 5349.30 TO E ¼ COR SEC 11, N2-43-10E 2663.88 TO NE COR SEC 10, S2-54-54W 2654.78 TO SE COR SEC 10, & ANGLE OF 89-44-25 @ W ¼ COR SEC 11 FROM CENTER OF SEC 11 TO SE COR SEC 10.

C) Was the corner restored through acceptance of (1) an obliterated evidence location, or, (2) a found perpetuated location?

ACCEPTED FOUND PERPETUATED PIPE.

I, Donald Barnes, hereby certify that the corner location as identified by the corner code index was determined by me under my direction and control and that this U.S. Public Land Survey Monument Record is correct and complete to the best of my knowledge and belief.

	seai	1
	01	
مدل ا	ald I	James
ρ.,	emboss	
	1 1	

11/4/79

Number of included sheets __1__

CORNER CODE G-17

A-E 7.08 REQUIREMENT

