

PLAT AND RECORD

Of a Survey on Section 22 T 3 R 14 E. of the 4 P. M. in Johnstown Township
Rock County, Wisconsin, made April the 31st 1895


I hereby certify that the following is a correct record of said survey as made by me.

COUNTY BUILDING
IN CITY OF БЕЛОIT

(Signed) P. F. Brown
PMB

County Surveyor.

The following plats & records were taken by me from the ^{field} notes
of the late O. G. Bleedorn (Signed) P. F. Brown
Co. Surveyor - for unexpired term.

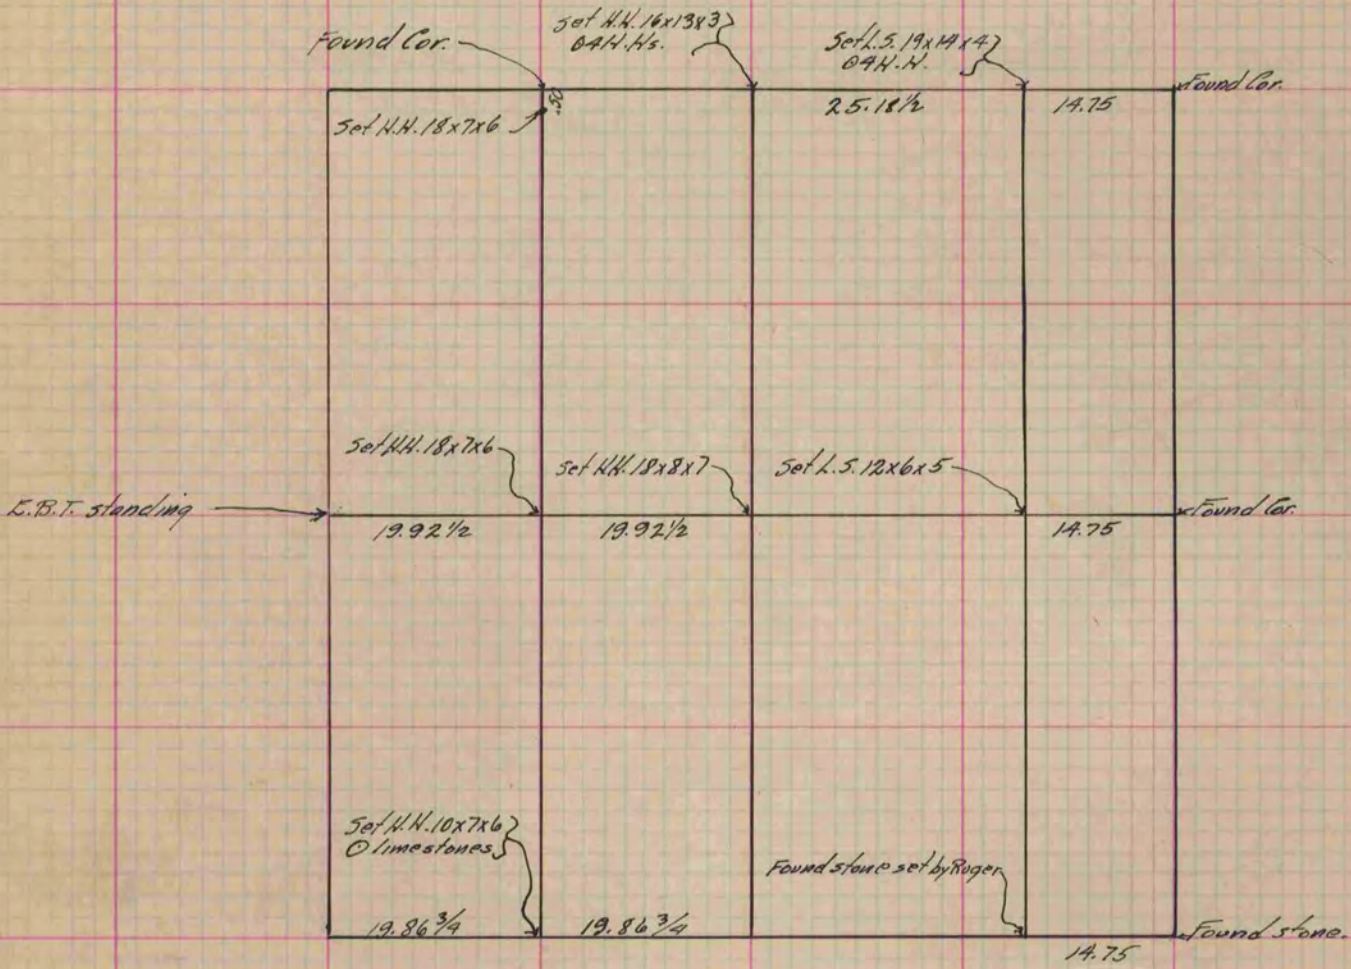

Copied from P. 278 Vol. 2 County Surveyor's Record.