

PLAT AND RECORD

Of a Survey on Section 22 T 4 R 14 E. of the 4 P. M. in Lima Township


Rock County, Wisconsin, made Apr. the 27 1896

I hereby certify that the following is a correct record of said survey as made by me.

COUNTY BUILDING
IN CITY OF БЕЛОIT

(Signed) P.F. Brown
P.F.B.

County Surveyor.

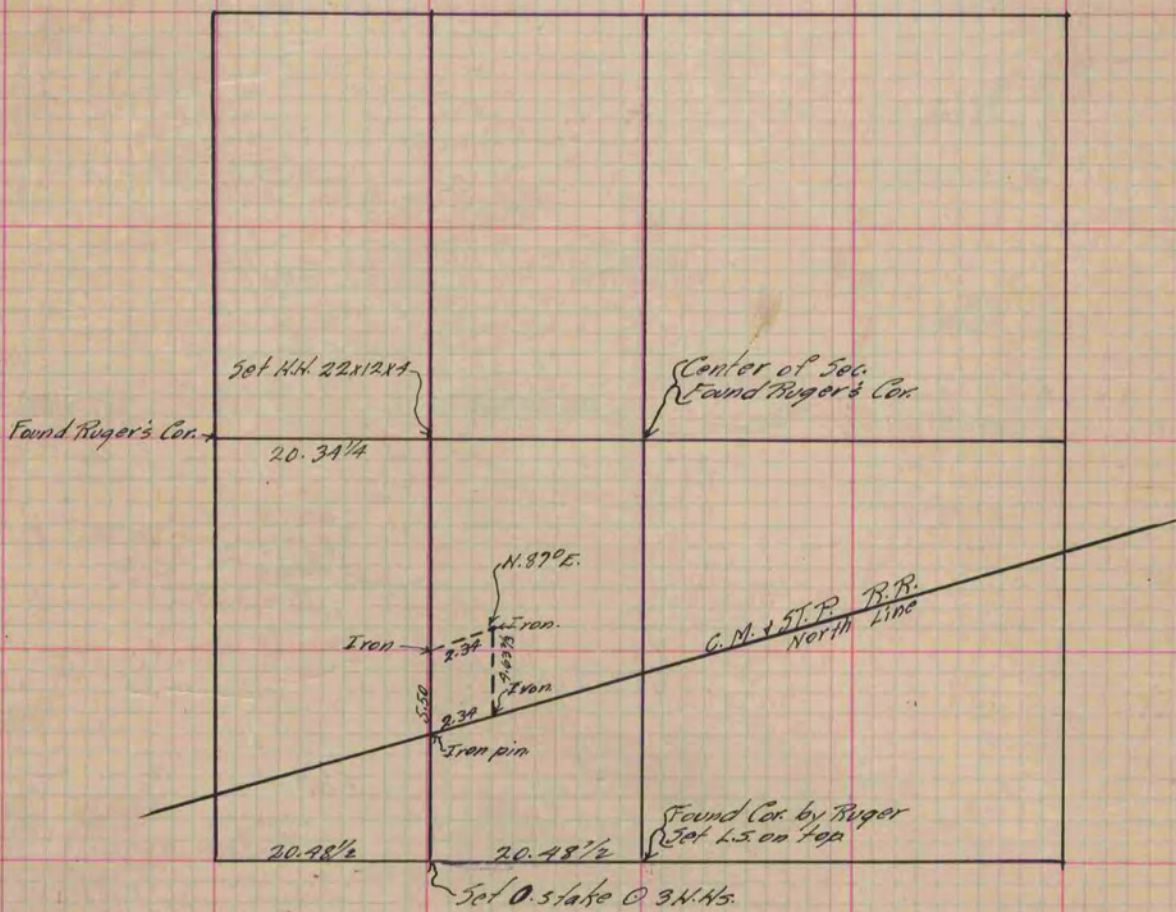

Copied from Page 382 Vol. 2 County Surveyor's Record.