

PUBLIC LAND SURVEY MONUMENT RECORD

For Public Land Survey Corners in the


T. 2 N., R. 11 E.

CORNER CODE INDEX

	1	2	3	4	5	6	7	8	9	10	11	12	13	14	15	16	17	18	19	20	21	22	23	24	25
A																									
B																									
C	8																								
D																									
E																									
F																									
G																									
H																									
I																									
J																									
K																									
L																									
M																									
N																									
O																									
P																									
Q																									
R																									
S																									
T																									
U																									
V																									
W																									
X																									
Y																									
Z																									

PLACE MONUMENT SYMBOL (◆) AT PROPER LOCATION ON ABOVE INDEX

EXAMPLE

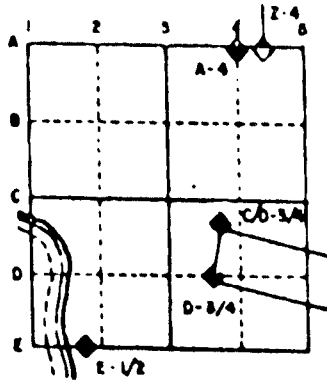

PLYMOUTH TWP
ROCK COUNTY WI

IF AVAILABLE
STATE PLANE COORDINATES

North (Y) _____ Elev. (Z) _____
 East (X) _____ Zone _____
 Hor. Datum _____ Vert. Datum _____

◆ CORNER MONUMENT

○ WITNESS MONUMENT

BEARINGS ARE BASED ON:

(B) Describe any record evidence, monument evidence, occupational evidence, testimonial evidence or any other material evidence you considered, and whether the monument was found or placed.

- 1865 LOCKE VOL 1 PG 240 SET HARDHEAD 17X2X11 WITH HH ON N& S. CALLS FOR 1310.76 TO CENTER OF SE 1/4 AND 1314.19 TO S 1/4 COR SEC 14.
- 1869 LEE VOL 2 PG 1 SET WHITE OAK STAKE SURROUNDED BY 4 LIMESTONES. CALLS FOR 1314.06 TO CENTER OF SE 1/4 SEC 11, 1329.08 TO S 1/4 COR SEC 11 AND CENTER OF SEC 11.
- 1871 RUGER VOL 2 PG 67 LIMESTONE 20 X 7 1/2 X 6 & FLAT LIMESTONE ON TOP OF IT 21X11X6. CALLS FOR 1321.24 TO S 1/4 COR & CENTER OF SEC 11.
- 1910 KERCH VOL 3 PG 61 SET GAS PIPE. FOUND STONE AT CENTER OF SEC 11 AND MON AT S 1/4 COR SEC 11. CALLS FOR 1326.0 TO S 1/4 COR AND 1309.35 TO CENTER OF SE 1/4 OF SEC 11. AN ANGLE OF 90-33-30 FROM CENTER OF SEC 11 TO S 1/4 COR SEC 11.

FOUND 2 1/2" GAS PIPE 0.6' DEEP AT EAST EDGE OF PVMT AND ON LINE WITH CENTERLINE OF E/W PAVEMENT. 1310.54 TO CENTER OF SE 1/4 SEC 11 & 1325.29 TO S 1/4 COR SEC 11.

C) Was the corner restored through acceptance of (1) an obliterated evidence location, or, (2) a found perpetuated location?
ACCEPTED FOUND PIPE.

D) Describe any material discrepancy between the location of the corner as restored or reestablished and the location of that corner as previously restored or reestablished by distance and direction. Show the discrepancy on the plan view drawing under (a), above. Show the distances between the corner as previously restored or reestablished and (1) the corner as restored or reestablished, and (2) to at least 4 of the witness monuments shown on the drawing in (a), above.

(E) Was the corner reestablished through lost corner proportionate methods? If so, show the method, including the directions and distances to other public land survey corners used as evidence or used for proportioning the corner location.
NO

I, Donald Barnes, hereby certify that the corner points as identified by the corner code index were, in a field survey on, MAY 18, 1995 established, re-established, monumented, re-monumented, recovered or restored as expressed below and in conformance with the regulations and rules as required in the current manual of survey instructions of the United States Department of Interior, Bureau of Land Management.

seal
May 19, 1995
Donald Barnes

EMBOSS LAND SURVEYOR SEAL

COUNTY SURVEYOR FILING DATA

Date of computer entry _____

Date microfilmed _____

Number of included sheets _____
CORNER CODE