

U.S. PUBLIC LAND SURVEY MONUMENT RECORD

For Public Land Survey Corners in the


T. 1 N., R. 13 E.

CORNER CODE INDEX

	1	2	3	4	5	6	7	8	9	10	11	12	13	14	15	16	17	18	19	20	21	22	23	24	25
A																									
B																									
C																									
D																									
E																									
F																									
G																									
H																									
I																									
J																									
K																									
L																									
M																									
N																									
O																									
P																									
Q																									
R																									
S																									
T																									
U																									
V																									
W																									
X																									
Y																									
Z																									

PLACE MONUMENT SYMBOL (◈) AT PROPER LOCATION ON ABOVE INDEX

EXAMPLE

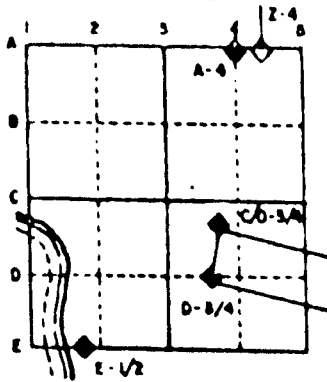

TURTLE TWP
ROCK COUNTY WI

IF AVAILABLE
STATE PLANE COORDINATES

North (Y) 222,165.91 Eleve. (Z) _____
East (X) 506,704.33 Zone _____
Hor. Datum COUNTY Vert. Datum _____

◈ CORNER MONUMENT

○ WITNESS MONUMENT

E 1/4 COR
SEC 8

FD POLY

N0-22-56E 2660.59

SE COR
SEC 8

S 1/4 COR
SEC 9

S 1/4 COR
SEC 8

N89-46-53W 2640.88
FD PIPE

S88-53-37E 2661.65 FD CI
FD 1" PIPE

S0-16-47W 2655.87

FD POLY

E 1/4 COR
SEC 17

BEARINGS ARE BASED ON COUNTY SYSTEM

TU545

(B) Describe any record evidence, monument evidence, occupational evidence, testimonial evidence or any other material evidence you considered, and whether the monument was found or placed.

- 1836 LYON SET POST CORNER TO SECTIONS 8,9,16,&17 & MADE MOUND OF EARTH & SOD.
- 1854 McVEAN VOL 1 PG 24 CALLS FOR 2636.7 TO S 1/4 COR SEC 11.
- 1882 LEE VOL 2 PG 368 FOUND OLD STAKE AT N SIDE OF FENCE POST, SAID TO HAVE BEEN SET BY A SURVEYOR FROM BELOIT. 2657.82 TO S 1/4 COR SEC 9.
- 1882 LEE VOL 2 PG 369 STATES NOTHING ABOUT CORNER. CALLS FOR 2640.99 TO S 1/4 COR SEC 8.
- 1882 HOLMES VOL 2 PG 356 STAKE AT N SIDE OF FENCE POST. 2670.36 TO S 1/4 COR SEC9, 2715.9 TO W 1/4 COR SEC 9.
- 1961 BATTERMAN VOL 4 PG 100 DUG & FOUND NOTHING. USED CENTER OF N/S FENCE TO CHAIN FROM 2640.62 TO S 1/4 COR SEC 8.
- 1964 BATTERMAN VOL 4 PG 204 DUG & FOND NOTHING SET 1" PIPE 2660.46 TO W 1/4 COR SEC 9,1330.72 TO S 1/16TH COR OF SW 1/4 SEC 9, & 2661.44 TO S 1/4 COR SEC 9.
- 1987 BARNES E-5 CALLS FOR RECORD DISTANCE OF 2660.46 (BATTERMAN 1964) TO W 1/4 COR SEC 9.

FD 1" PIPE.

C) Was the corner restored through acceptance of (1) an obliterated evidence location, or, (2) a found perpetuated location?
ACCEPTED FOUND PERPETUATED LOCATION.

D) Describe any material discrepancy between the location of the corner as restored or reestablished and the location of that corner as previously restored or reestablished by distance and direction. Show the discrepancy on the plan view drawing under (a), above. Show the distances between the corner as previously restored or reestablished and (1) the corner as restored or reestablished, and (2) to at least 4 of the witness monuments shown on the drawing in (a), above.

(E) Was the corner reestablished through lost corner proportionate methods? If so, show the method, including the directions and distances to other public land survey corners used as evidence or used for proportioning the corner location.
NO

I, Donald Barnes, hereby certify that the corner points as identified by the corner code index were, in a field survey on,1994, established, re-established, monumented, re-monumented, recovered or restored as expressed below and in conformance with the regulations and rules as required in the current manual of survey instructions of the United States Department of Interior, Bureau of Land Management.

seal
Donald Barnes
7/11/95

EMBOSS LAND SURVEYOR SEAL

COUNTY SURVEYOR FILING DATA

Date of computer entry _____

Date microfilmed _____

Number of included sheets _____
CORNER CODE _____