

PUBLIC LAND SURVEY MONUMENT RECORD


For Public Land Survey Corners in the
T. 1 N., R. 13 E.

CORNER CODE INDEX

	1	2	3	4	5	6	7	8	9	10	11	12	13	14	15	16	17	18	19	20	21	22	23	24	25
A																									
B																									
C	6																								
D		5																							
E			4																						
F				3																					
G					2																				
H																									
I																									
J																									
K																									
L																									
M																									
N																									
O																									
P																									
Q																									
R																									
S																									
T																									
U																									
V																									
W																									
X																									
Y																									
Z																									

PLACE MONUMENT SYMBOL (◆) AT PROPER LOCATION ON ABOVE INDEX

EXAMPLE

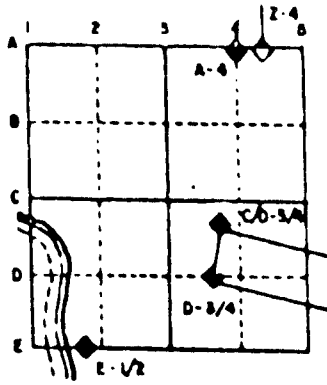

TURTLE TWP
ROCK COUNTY WI

IF AVAILABLE STATE PLANE COORDINATES

North (Y) _____ Elev. (Z) _____
 East (X) _____ Zone _____
 Hor. Datum _____ Vert. Datum _____

◆ CORNER MONUMENT

○ WITNESS MONUMENT

BEARINGS ARE BASED ON:

(B) Describe any record evidence, monument evidence, occupational evidence, testimonial evidence or any other material evidence you considered, and whether the monument was found or placed.

- 1864 LOCKE VOL 1 PG 204 FOUND OLD STAKE & E BT & STUMP OF N. BT. SET BR OAK STAKE IN CENTER OF A HEAP OF LIMESTONE. CALLS FOR 2655.84 TO CENTER OF SEC 10, 5311.68 VAR 5-12 TO W 1/4 COR SEC 10, 2649.24 VAR 6-55 TO SE COR SEC 10.
- 1864 LOCKE VOL 1 PG 207 SEE SEC 10. CALLS FOR 2637.36 TO CENTER OF SEC 11 & 5274.72 TO E 1/4 COR SEC 11.
- 1882 HOLMES VOL 2 PG 346 FD STONES & SOME ROTTEN WOOD & STUMP OF E. BT. DROVE BUR OAK STAKE. CALLS FOR 2644.62 TO CENTER OF SEC 11.
- 1970 BATTERMAN VOL 4 PG 475 FOUND 1" PIPE SURROUNDED BY HHS & LIMESTONE. SET CONCRETE MONUMENT WITH BRASS CAP.

FOUND CONCRETE MONUMENT WITH BRASS CAP.

C) Was the corner restored through acceptance of (1) an obliterated evidence location, or, (2) a found perpetuated location?
ACCEPTED FOUND PERPETUATED LOCATION.

D) Describe any material discrepancy between the location of the corner as restored or reestablished and the location of that corner as previously restored or reestablished by distance and direction. Show the discrepancy on the plan view drawing under (a), above. Show the distances between the corner as previously restored or reestablished and (1) the corner as restored or reestablished, and (2) to at least 4 of the witness monuments shown on the drawing in (a), above.

(E) Was the corner reestablished through lost corner proportionate methods? If so, show the method, including the directions and distances to other public land survey corners used as evidence or used for proportioning the corner location.
NO

I, Donald Barnes, hereby certify that the corner points as identified by the corner code index were, in a field survey on, 1994, established, re-established, monumented, re-monumented, recovered or restored as expressed below and in conformance with the regulations and rules as required in the current manual of survey instructions of the United States Department of Interior, Bureau of Land Management.

seal

Donald Barnes
7/13/95

COUNTY SURVEYOR FILING DATA

Date of computer entry _____

Date microfilmed _____

Number of included sheets _____
CORNER CODE

EMBOSS LAND SURVEYOR SEAL

A-E 7.08 REQUIREMENT

617