

PUBLIC LAND SURVEY MONUMENT RECORD

For Public Land Survey Corners in the


T. 1 N., R. 13 E.

CORNER CODE INDEX

	1	2	3	4	5	6	7	8	9	10	11	12	13	14	15	16	17	18	19	20	21	22	23	24	25
A																									
B	6																								
C		5																							
D			4																						
E				3																					
F					2																				
G																									
H	7																								
I		6																							
J			5																						
K				4																					
L					3																				
M						2																			
N							1																		
O																									
P	8																								
Q		20																							
R			21																						
S				22																					
T					23																				
U						24																			
V							25																		
W	30																								
X		29																							
Y			28																						
Z				27																					
AA					26																				
AB						25																			
AC							24																		
AD								23																	
AE									22																
AF										21															
AG											20														
AH												19													
AI													18												
AJ														17											
AK															16										
AL																15									
AM																	14								
AN																		13							
AO																			12						
AP																				11					
AQ																					10				
AR																						9			
AS																							8		
AT																								7	
AU																									6
AV																									5
AW																									4
AX																									3
AY																									2
AZ																									1

PLACE MONUMENT SYMBOL (●) AT PROPER LOCATION ON ABOVE INDEX

EXAMPLE

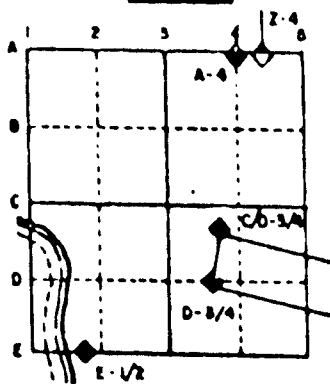

TURTLE TWP
ROCK COUNTY WI

IF AVAILABLE
STATE PLANE COORDINATES

North (Y) 219,240.81 Eleve. (Z) _____
 East (X) 519,308.23 Zone _____
 Hor. Datum COUNTY Vert. Datum _____

◆ CORNER MONUMENT

○ WITNESS MONUMENT

Fd DISK IN CONCRETE



NE COR *Fd* 1 1/2' PIPE
SEC 15

Fd DISK
IN CONCRETE
W 1/4 COR
SEC 15

N88-23-23W 5302.76

Fd DISK
IN CONCRETE

N0-54-47E 2648.14

E 1/4 COR
SEC 15

S88-28-04E 5334.14

E 1/4 COR
SEC 14

Fd DISK
IN CONCRETE

S0-17-34W 2646.62

SE COR
SEC 15

Fd CI

SHEET _____ OF _____

117

CORNER CODE _____

TU558

(B) Describe any record evidence, monument evidence, occupational evidence, testimonial evidence or any other material evidence you considered, and whether the monument was found or placed.

- 1836 LYON SET QUARTER SECTION POST BUR OAK 15 N83 1/4W 56 & BUR OAK 6 N50 1/2E 70 CALLS FOR 2640 TO NE & SE CORNERS OF SECTION 15.
- 1854 McVEAN VOL 1 PG 25 2650.89 TO NW COR SEC 14.
- 1970 BATTERMAN VOL 4 PG 475 FOUND 2" PIPE SURROUNDED BY HARD HEADS. SET CONC. MON. WITH BRASS CAP.
- 1971 LEE VOL 4 PG 548 2649.19 TO NW 14,2646.68 TO SW 14,2674.43 TO CENTER SEC 14,5334.14 TO E 1/4 COR SEC 14,AN ANGLE OF 90-36-39 FROM NW COR SEC 14 TO CENTER OF SEC 14.
- 1974 WI DOT VOL 6 PG 55&120 R/W MAPS. CONC. NAD27 200,811.67;2,287,371.18.

FOUND DISK IN CONCRETE.

C) Was the corner restored through acceptance of (1) an obliterated evidence location, or, (2) a found perpetuated location?

ACCEPTED FOUND PERPETUATED LOCATION.

D) Describe any material discrepancy between the location of the corner as restored or reestablished and the location of that corner as previously restored or reestablished by distance and direction. Show the discrepancy on the plan view drawing under (a), above. Show the distances between the corner as previously restored or reestablished and (1) the corner as restored or reestablished, and (2) to at least 4 of the witness monuments shown on the drawing in (a), above.

(E) Was the corner reestablished through lost corner proportionate methods? If so, show the method, including the directions and distances to other public land survey corners used as evidence or used for proportioning the corner location.

NO

I, Donald Barnes, hereby certify that the corner points as identified by the corner code index were, in a field survey on,1995, established, re-established, monumented, re-monumented, recovered or restored as expressed below and in conformance with the regulations and rules as required in the current manual of survey instructions of the United States Department of Interior, Bureau of Land Management.

seal

Donald Barnes
7/12/95

EMBOSS LAND SURVEYOR SEAL

COUNTY SURVEYOR FILING DATA

Date of computer entry _____

Date microfilmed _____

Number of included sheets _____
CORNER CODE