

PUBLIC LAND SURVEY MONUMENT RECORD


For Public Land Survey Corners in the
T. 1 N., R. 13 E.

CORNER CODE INDEX

	1	2	3	4	5	6	7	8	9	10	11	12	13	14	15	16	17	18	19	20	21	22	23	24	25
A																									
B																									
C																									
D																									
E																									
F																									
G																									
H																									
I																									
J																									
K																									
L																									
M																									
N																									
O																									
P																									
Q																									
R																									
S																									
T																									
U																									
V																									
W																									
X																									
Y																									
Z																									

PLACE MONUMENT SYMBOL (◆) AT PROPER LOCATION ON ABOVE INDEX

EXAMPLE

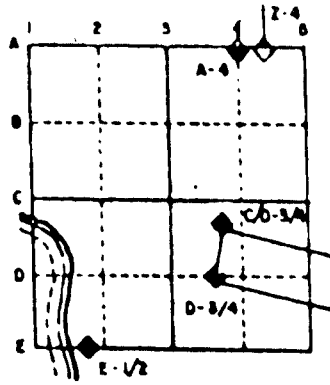

TURTLE TWP
ROCK COUNTY WI

IF AVAILABLE STATE PLANE COORDINATES

North (Y) 214,217.22 Elevation (Z) _____
 East (X) 496,297.16 Zone _____
 Hor. Datum COUNTY Vert. Datum _____

◆ CORNER MONUMENT
Fd DISK IN
CONCRETE

○ WITNESS MONUMENT

Fd TIE IN VOL 15 PG 305

BEARINGS ARE BASED ON:

TU574

(B) Describe any record evidence, monument evidence, occupational evidence, testimonial evidence or any other material evidence you considered, and whether the monument was found or placed.

1836

1859 HOBART VOL 1 PG 105 STATES NOTHING ABOUT MONUMENT VAR 0-29E 2647.92 TO SW CORNER OF SEC 19 & N89-57W 5075.40 TO E 1/4 COR SEC 19. N89-47E 2412.96 FROM SW TO S 1/4 CORNERS OF SECTION 19.

1911 KERCH VOL 3 PG 69 FOUND STONE OVER STAKE SURROUNDED BY BRICKS SET PIECE OF CAST IRON LAMP POST 4" TO 6" DIAMETER. 2641.5 TO NW COR SEC 19, 2643.5 TO SW CORNER SEC 19, 89-28-30 AT W 1/4 COR SEC 19 FROM NW TO E 1/4 CORNERS OF SEC 19, ANGLE OF 90-31-30 AT W 1/4 COR SEC 19 FROM E 1/4 TO SW CORNERS OF SEC 19, ANGLE OF 90-37-45 AT NW CORNER SEC 19 FROM N 1/4 COR TO W 1/4 CORNERS OF SECTION 19, AND ANGLE OF 89-20 AT SW CORNER FROM W 1/4 TO S 1/4 CORNERS OF SECTION 19.

1936 SUNNY VOL 3 PG 297 FOUND CAST IRON WAGON WHEEL HUB & LIMESTONE MONUMENT 12" LOW. SET 1 1/2X 12" PIPE MONUMENT CAPPED. REFERENCED SAME.

1960 BATTERMAN VOL 4 PG 55 STATES NOTHING ABOUT MONUMENT. REFERENCES CORNER.

1976 BARNES VOL 5 PG 178 FOUND 3/4 BAR & REFERENCED SAME.

1977 BARNES VOL 5 PG 305 SET CAP IN CONCRETE FROM TIES. PIPE 3.18 TO SOUTH.

19?? VOL 6 PG 312 FOUND CAST IRON WAGON WHEEL HUB 10" LOW WITH LIMESTONE SOUTH SIDE. REFERENCED SAME.

FOUND DISK IN CONCRETE. ANGLE OF 89-28-34 (REC 89-28-30) AT W 1/4 FROM NW TO E 1/4 CORNERS OF SEC 19, ANGLE OF 90-31-21 (REC 90-31-30) AT W 1/4 COR FROM E 1/4 TO SW CORNERS OF SEC 19, ANGLE OF 90-37-43 (REC 90-37-45) AT NW FROM N 1/4 TO W 1/4 CORNERS OF SEC 19, ANGLE OF 89-22-36 (REC 88-20-20) AT SW COR FROM W 1/4 COR TO S 1/4 CORNERS OF SEC 19.

C) Was the corner restored through acceptance of (1) an obliterated evidence location, or, (2) a found perpetuated location?
ACCEPTED FOUND PERPETUATED LOCATION.

D) Describe any material discrepancy between the location of the corner as restored or reestablished and the location of that corner as previously restored or reestablished by distance and direction. Show the discrepancy on the plan view drawing under (a), above. Show the distances between the corner as previously restored or reestablished and (1) the corner as restored or reestablished, and (2) to at least 4 of the witness monuments shown on the drawing in (a), above.

(E) Was the corner reestablished through lost corner proportionate methods? If so, show the method, including the directions and distances to other public land survey corners used as evidence or used for proportioning the corner location.

NO

I, Donald Barnes, hereby certify that the corner points as identified by the corner code index were, in a field survey on, 1995, established, re-established, monumented, re-monumented, recovered or restored as expressed below and in conformance with the regulations and rules as required in the current manual of survey instructions of the United States Department of Interior, Bureau of Land Management.

COUNTY SURVEYOR FILING DATA

Date of computer entry _____

Date microfilmed _____

Number of included sheets _____
CORNER CODE

seal
Donald Barnes
7/11/95

EMBOSS LAND SURVEYOR SEAL