
U.S. PUBLIC LAND SURVEY MONUMENT RECORD

For Public Land Survey Corners in:

WI ADMINISTRATIVE CODE A-E 7.08 REQUIREMENT

T. _/N., R. /3_E

CORNER CODE INDEX

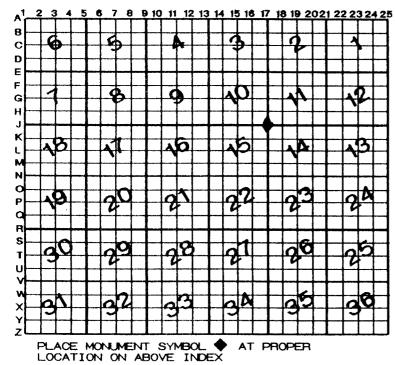

TU	IRTLE	TWI
	COUNTY	

IF AVAILABLE
ROCK COUNTY COORDINATES PERFERRED

North Elev
East
Hor. Datum Vert. Datum
LATITUDEELLIPS. H
LONGITUTE
GPS (X) TRAVERSE (X)
BASED ON THE FOLLOWING CONTROL:

♦ CORNER MONUMENT

O WITNESS MONUMENT

BEARINGS ARE BASED ON:

(a)

		1 0	>
FIELD BOOKPAGE	= #	SHEET OF 2	
SHOW A PLAN VIEW DRAWII	NG DEPICTING THE CORNER MONUMENT AN	D SURROUNDING	
PHYSICAL FEATURES, INCLUE	DING THE EXCAVATION AREA AND DEPTH.		
PLANNING & ZONING COMMITTEE	ADOPTED THE ABOVE FORM ON 12/2/1982		

TU549

- (B) Describe any record evidence, monument evidence, occupational evidence, testimonial evidence or any other material evidence you considered, and whether the monument was found or placed.
- 1836 LYON SET POST CORNER TO SECTIONS 10,11,14,&15. BUR OAK 30 S61E 60 & BUR OAK 15 S56W 116
- 1854 McVEAN VOL 1 PG 25 2650.89 TO W 1/4 COR SEC 14 & 2654.52 TO N 4 COR SEC 14.
- 1864 LOCKE VOL 1 PG 207 SEE SEC 10 2642.64 VAR 5-37 TO S $\frac{1}{4}$ COR SEC 11.
- 1864 LOCKE VOL 1 PG 204 FOUND STUMPS OF BTS & OLD STAKE. SET LARGE BR OAK STAKE IN CENTER OF HEAP OF LIMESTONES. SMALL POPLAR ABOUT 3" E-SE OF STAKE. 2654.52 VAR 5-00 TO S 1/4 COR SEC 10 & 2649.24 VAR 6-55 TO E 1/4 COR SEC 10.
- 1970 BATTERMAN VOL 4 PG 475 FOUND LIMESTONE AT CORNER. SET CONC. MON. WITH BRASS CAP.
- 1971 LEE VOL 4 PG 548 2658.83 TO N 1/4 COR SEC 14,2649.19 TO W 4 COR SEC 14,& AN ANGLE OF 89-24-24 AT NW COR SEC 14 FROM THE N 4 TO W CORNERS OF SEC 14.
- 1974 WI DOT R/W MAP CONCRET MONUMENT. NAD 27 203,459.96; 2,287,385.05.

FOUND 1 12" PIPE

- C) Was the corner restored through acceptance of (1) an obliterated evidence location, or, (2) a found perpetuated location?

 ACCEPTED FOUND PERPETUATED LOCATION
- D) Describe any material discrepancy between the location of the corner as restored or reestablished and the location of that corner as previously restored or reestablished by distance and direction. Show the discrepancy on the plan view drawing under (a), above. Show the distances between the corner as previously restored or reestablished and (1) the corner as restored or reestablished, and (2) to at least 4 of the witness monuments shown on the drawing in (a), above.
- (E) Was the corner reestablished through lost corner proportionate methods? If so, show the method, including the directions and distances to other public land survey corners used as evidence or used for proportioning the corner location. $^{\rm NO}$

I, Donald Barnes, hereby certify that the corner points as identified by the corner code index were, in a field survey on 1994, established, re-established, monumented, re-monumented, recovered or restored as expressed below and in conformance with the regulations and rules as required in the current manual of survey instructions of the United States Department of Interior, Bureau of Land Management.

Durch Barres

COUNTY SURVEYOR FILING DATA	*
Date of computer entry	
Date microfilmed	
Number of included sheets	/
CORNER CODE	

