

PUBLIC LAND SURVEY MONUMENT RECORD


For Public Land Survey Corners in the
T. 1 N., R. 13 E.

CORNER CODE INDEX

	1	2	3	4	5	6	7	8	9	10	11	12	13	14	15	16	17	18	19	20	21	22	23	24	25
A																									
B																									
C																									
D																									
E																									
F																									
G																									
H																									
I																									
J																									
K																									
L																									
M																									
N																									
O																									
P																									
Q																									
R																									
S																									
T																									
U																									
V																									
W																									
X																									
Y																									
Z																									

PLACE MONUMENT SYMBOL (◈) AT PROPER LOCATION ON ABOVE INDEX

EXAMPLE

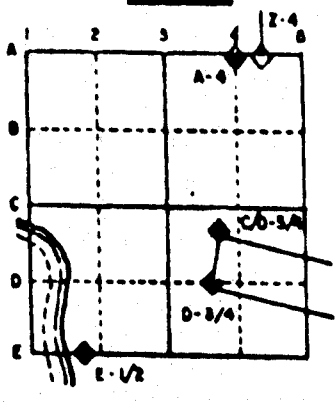

TURTLE TWP
ROCK COUNTY WI

IF AVAILABLE
STATE PLANE COORDINATES

North (Y) 222,175.99 Eleve. (Z) _____
East (X) 504,063.46 Zone _____
Hor. Datum COUNTY Vert. Datum _____

◈ CORNER MONUMENT

○ WITNESS MONUMENT

BEARINGS ARE BASED ON

(B) Describe any record evidence, monument evidence, occupational evidence, testimonial evidence or any other material evidence you considered, and whether the monument was found or placed.

- 1836 LYON SET QUARTER SECTION POST & MADE MOUND OF EARTH & SOD. CALLS FOR 2640 TO SE & SW CORNERS OF SEC 8.
- 1854 McVEAN VOL 1 PG 24 CENTER OF CREEK ON N/S CENTER LINE OF SEC 8 TO S 1/4 COR SEC 8 IS 3587.1.
- 1882 LEE VOL 2 PG 369 1/4 CORNER AGREED UPON AS BEING IN CENTER OF ROAD. 2640.99 TO SE COR SEC 8. USED TO SUBDIVIDE SEC 8. 2647.92 FROM CENTER 8 TO E 1/4 COR SEC 8.
- 1961 BATTERMAN VOL 4 PG 100 SET CONCRETE MONUMENT USING R.H. LEE'S MEASUREMENT. REFERENCED SAME. SHOWS CORNER IS 3.7' EAST OF CENTER OF PAVEMENT & 2640.62 TO SE COR SEC 8.

FOUND 1" PIPE 0.4' DEEP & 3 REFERENCE PIPES. 2640.96 TO SE COR SEC 8.

C) Was the corner restored through acceptance of (1) an obliterated evidence location, or, (2) a found perpetuated location?
ACCEPTED FOUND PERPETUATED LOCATION.

D) Describe any material discrepancy between the location of the corner as restored or reestablished and the location of that corner as previously restored or reestablished by distance and direction. Show the discrepancy on the plan view drawing under (a), above. Show the distances between the corner as previously restored or reestablished and (1) the corner as restored or reestablished, and (2) to at least 4 of the witness monuments shown on the drawing in (a), above.

(E) Was the corner reestablished through lost corner proportionate methods? If so, show the method, including the directions and distances to other public land survey corners used as evidence or used for proportioning the corner location.
NO

I, Donald Barnes, hereby certify that the corner points as identified by the corner code index were, in a field survey on, NOV 23, 1994, established, re-established, monumented, re-monumented, recovered or restored as expressed below and in conformance with the regulations and rules as required in the current manual of survey instructions of the United States Department of Interior, Bureau of Land Management.

seal
Donald Barnes
6/24/95

COUNTY SURVEYOR FILING DATA

Date of computer entry _____

Date microfilmed _____

Number of included sheets _____

CORNER CODE

EMBOSS LAND SURVEYOR SEAL

