
U.S.

SURVEY TUBLIC MONUMENT RECORD

For Public Land Survey Corners in the T. 1M, R. 13 E

CORNER CODE INDEX

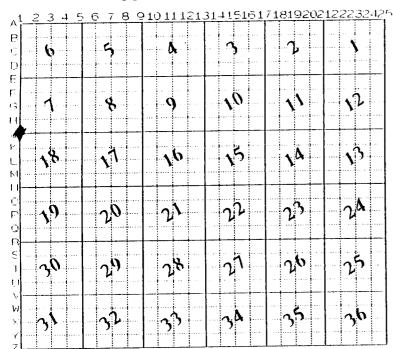

TUR	TLE	TW	7 1
ROCK	COUNTY	WI	

IF AVAILABLE ROCK COUNTY COORDITIATES PERFERRED

North 222,142,58 Elev.

East 496,364,22

Hor. Datum COUNTY Vert. Datum

GPS (X)

TRAVERSE (X)

BASED ON THE FOLLOWING CONTROL:

PLACE MONUMENT SYMBOL & LOCATION ON ABOVE INDEX

CORNER MONUMENT

O WITHESS MONUMENT

(a)

Fd MON BOX

VOL 4 PG 56

BEARINGS ARE BASED ON:

FEATURES, INCLUDING THE EXCAVATION AREA AND DEPTH. THE CORNER MOREMENT SHALL HAVE.

S. 20 JF BROKET LEAVE A PERMALENTLY MAGNETIZED REMAINT AT THE ORIGINAL POINT.

BLALLY FOR DISTURBING MARKET. 50 OR AN EXISTING CUT LINESTONE. AN IRVEDIFE 1 02'V

BLACE. IF THE CORNER IS OCCUPIED BY AN INFROMERING BRADINGERUTIED CARLESTO. AND

STAIN DRIBBE WITHESS HOWERED IS WITHESS MOMEMBERS SHALL BE MADE OF CONTROL MILITIAL

OTHER WITHESS MODIFIEDS.

PLAINING & ZOMING COMMITTEE ADMRTED THE ABOVE FORM ON 12/2/199. WI ADMINISTRATIVE CODE A-E 7.08 REQUIREMENT

SHEET ____OF ___

(B) Describe any record evidence, monument evidence, occupational evidence, testimonial evidence or any other material evidence you considered, and whether the monument was found or placed.

considered, and whether the monument was found or placed.

1936 SUNNY VOL 3 PG 296 FOUND IRON ROD 12" LOW. SET 1 1/2" PIPE/CAP ON TOP. REFERENCED CORNER.

1957 BATTERMAN VOL 3 PG 510 FOUND PIPE. CALLS FOR 2645.7 TO W 1/4 COR SEC 18.

1960 BATTERMAN VOL 4 PG 56 REFERENCED CORNER.

FOUND 1" PIPE IN MON. BOX & TIES THAT IN VOL 4 PG 56.

- C) Was the corner restored through acceptance of (1) an obliterated evidence location, or, (2) a found perpetuated location? ACCEPTED FOUND PERPETUATED LOCATION.
- D) Describe any material discrepancy between the location of the corner as restored or reestablished and the location of that corner as previously restored or reestablished by distance and direction. Show the discrepancy on the plan view drawing under (a), above. Show the distances between the corner as previously restored or reestablished and (1) the corner as restored or reestablished, and (2) to at least 4 of the witness monuments shown on the drawing in (a), above.
- (E) Was the corner reestablished through lost corner proportionate methods? If so, show the method, including the directions and distances to other public land survey corners used as evidence or used for proportioning the corner location.

I, Donald Barnes, hereby certify that the corner points as identified by the corner code index were, in a field survey on,1994, established, re-established, monumented, re-monumented, recovered or restored as expressed below and in conformance with the regulations and rules as required in the current manual of survey instructions of the United States Department of Interior, Bureau of Land Management.

COUNTY SURVEYOR FILING DATA

Date of computer entry____

Date microfilmed

Number of included sheets CORNER CODE

A-E 7.08 REQUIREMENT

seal

EMBOSS LAND SURVEYOR SEAT.