

U.S. PUBLIC LAND AND SURVEY MONUMENT RECORD

For Public Land Survey Corners in the

T. 1N, R. 13E

CORNER CODE INDEX

TURTLE TWP
ROCK COUNTY WI

A	1	2	3	4	5	6	7	8	9	10	11	12	13	14	15	16	17	18	19	20	21	22	23	24	25	26	27	28	29	30	31	32	33	34	35	36			
B																																							
C																																							
D																																							
E																																							
F																																							
G																																							
H																																							
I																																							
J																																							
K																																							
L																																							
M																																							
N																																							
O																																							
P																																							
Q																																							
R																																							
S																																							
T																																							
U																																							
V																																							
W																																							
X																																							
Y																																							
Z																																							

IF AVAILABLE
ROCK COUNTY COORDINATES REFERRED


North 216,859.35 Elev. _____

East 496,317.12

Hor. Datum COUNTY Vert. Datum _____

GPS (X) _____ TRAVERSE (X)

BASED ON THE FOLLOWING CONTROL:

PLACE MONUMENT SYMBOL  AT PROPER LOCATION ON ABOVE INDEX

 CORNER MONUMENT

WITNESS MONUMENT

(a)

BEARINGS ARE BASED ON:

FIELD BOOK _____ PAGE # _____

SHOW A PLAN VIEW DRAWING DEPICTING THE CORNER MONUMENT AND SURROUNDING PHYSICAL FEATURES, INCLUDING THE EXCAVATION AREA AND DEPTH. THE CORNER MONUMENT SHALL HAVE THE FOLLOWING CHARACTERISTICS: 1) HAVE A LEAST TWO PREDETERMINED BREAK-OFF POINTS. 2) IF BROKEN, LEAVE A PERMANENTLY MAGNETIZED REMNANT AT THE ORIGINAL POINT. 3) MUST BE EXTENDABLE. 4) THE CAP IS INSCRIBED "ROCK COUNTY SURVEY MONUMENT" PENALTY FOR DISTURBING MARKER. 5) OR AN EXISTING QUI LINESHOLE. AN IRON PIPE 1 1/2" DIA. BURNING MAY BE USED IN AREAS WHERE GROUND WATER IS WITHIN ONE FOOT OF THE SURFACE. IF THE CORNER IS OCCUPIED BY AN IMPROVEMENT (HOLE, BURIED CABLE, ETC) AND DURABLE, DISTINCT MATERIAL MAY BE USED. CORNERS SHALL BE REFERENCED WITH AT LEAST 4 DURABLE WITNESS INSTRUMENTS. WITNESS MONUMENTS SHALL BE MADE OF CONCRETE, METAL, STONE, IRON OR OTHER EQUALLY DURABLE MATERIAL EXCEPT WOOD. DESCRIBE THE CORNER AND THE WITNESS MONUMENTS.

SHEET 1 OF 2

PLANNING & ZONING COMMITTEE ADOPTED THE ABOVE FORM ON 12/2/1992
WI ADMINISTRATIVE CODE A-E 7.09 REQUIREMENT

CORNER CODE

NI

TU561

(B) Describe any record evidence, monument evidence, occupational evidence, testimonial evidence or any other material evidence you considered, and whether the monument was found or placed.

1835 BRINK SET POST CORNER SECTIONS 13 & 24 IN PRAIRIE. MOUND PIT SOUTH OF POST 4.62'.

1836 LYON INTERSECTED RANGE LINE 38.94' NORTH OF POST. CALLS FOR 2434.08' TO S 1/4 COR SEC 18.

1911 KERCH VOL 3 PG 69 FOUND LIMESTONE. SET 1 1/2" GAS PIPE 30" LONG IN CENTER OF LOTS OF STONES. CALLS FOR 2438.4' TO N 1/4 CORNER OF SECTION 19, 2641.5' TO W 1/4 CORNER OF SECTION 19, & ANGLE 90-37'-45" AT NW CORNER FROM N 1/4 CORNER TO W 1/4 CORNERS OF SECTION 19.

1936 SUNNY VOL 3 PG 297 FOUND 1 1/2" PIPE MONUMENT 12" LOW. SET 1 1/2" PIPE CAPPED ON TOP. SET TIES.

1955 SHIMEALL MAP #4771 CALLS FOR PIPE AND 2644.03 TO THE W 1/4 CORNER OF SECTION 18.

1959 BATTERMAN JR. PLAT 20 PG 1 FOUND CAPPED PIPE.

1959 SHIMEALL "BERRY HILL SUB" PLAT 18 PG 21 FD 2" PIPE. ANGLE AT NW 19 FROM N 1/4 TO W 1/4 CORNERS OF SECTION 19.

1960 BATTERMAN JR VOL 4 PG 55 FOUND 1 1/2": CAPPED PIPE. SET REFERENCE PIPES.

1962 BATTERMAN JR. "NORTH GATE FIRST ADDITION" PLAT 21 PG 18. CALLS FOR MONUMENT AND TIED PLAT INTO IT.

C) Was the corner restored through acceptance of (1) an obliterated evidence location, or, (2) a found perpetuated location?

PAVEMENT IS CONCRETE. DID NOT DIG FOR MONUMENT. RECORD DISTANCES AND ANGLES FIT WELL. RESTORED THROUGH ACCEPTANCE OF OBLITERATED EVIDENCE LOCATION AS SHOWN IN MAP.

D) Describe any material discrepancy between the location of the corner as restored or reestablished and the location of that corner as previously restored or reestablished by distance and direction. Show the discrepancy on the plan view drawing under (a), above. Show the distances between the corner as previously restored or reestablished and (1) the corner as restored or reestablished, and (2) to at least 4 of the witness monuments shown on the drawing in (a), above.

(E) Was the corner reestablished through lost corner proportionate methods? If so, show the method, including the directions and distances to other public land survey corners used as evidence or used for proportioning the corner location.

NO

I, Donald Barnes, hereby certify that the corner points as identified by the corner code index were, in a field survey on, MAY 5, 1992, established, re-established, monumented, re-monumented, recovered or restored as expressed below and in conformance with the regulations and rules as required in the current manual of survey instructions of the United States Department of Interior, Bureau of Land Management.

COUNTY SURVEYOR FILING DATA

Date of computer entry _____

Date microfilmed _____

Number of included sheets _____
CORNER CODE

seal

Donald Barnes
7/11/95

AFFIX YOUR LAND SURVEYOR SEAL

N/

N0-31-10E 70.21

FD 1 1/2" PIPE

REC 35.00
35.00

FD 2 1/2" PIPE

S89-33-58E 90.11
REC 90.00
N78-43-51E
173.68

S77-56-11E
137.53

S89-34-01E 90.05
REC 90.05

12" DEEP
FD 2 1/2" PIPE

REC 35.00
35.00

FD 2 1/2" PIPE

79.96

S67-33-28
N66-39-51E
71.90
N45-14-28E
REC 50.00
55.67

S65-55-00E 87.24
REC 90.04-40
90-04-47
REC 90.04-40
180-00-00

79.96

SECTION LINE

PRAIRIE AVE.

S89-59-57
89-59-40
180-04-20
180-04-44
REC 102.61
N79-53-49E
REC 50.22

S89-17-35
REC 89-17-35

FD PIPE


REC 33.00
32.79

MURPHY WOODS RD

N89-52-59E 164.78
REC 165.00

FD PIPE REC 33.00
33.02

S81-26-59E 217.17

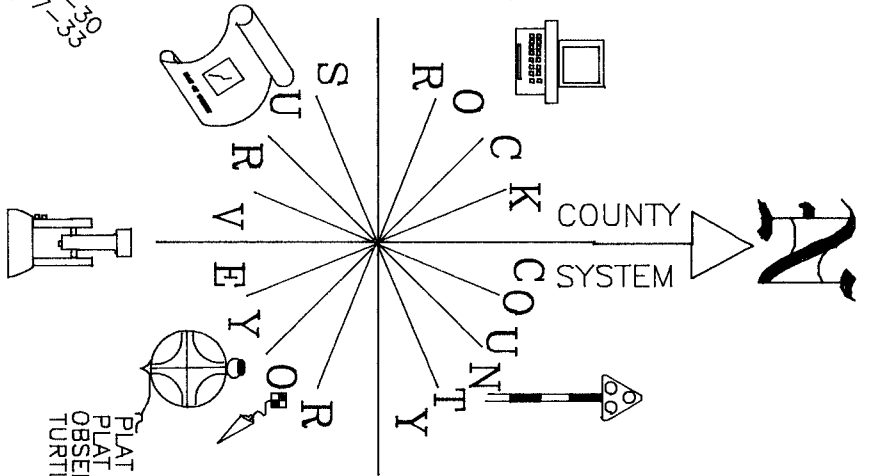

PLAT BOOK 18 PG 21
PLAT BOOK #21 PG 18
OBSERVATION SHEET 814
TURTLE TWP PROJECT

Donald Barnes
3/3/95

N1