

PUBLIC LAND SURVEY MONUMENT RECORD

For Public Land Survey Corners in the


T. 1 N., R. 13 E.

CORNER CODE INDEX

	1	2	3	4	5	6	7	8	9	10	11	12	13	14	15	16	17	18	19	20	21	22	23	24	25
A																									
B																									
C																									
D																									
E																									
F																									
G																									
H																									
I																									
J																									
K																									
L																									
M																									
N																									
O																									
P																									
Q																									
R																									
S																									
T																									
U																									
V																									
W																									
X																									
Y																									

PLACE MONUMENT SYMBOL (◆) AT PROPER LOCATION ON ABOVE INDEX

EXAMPLE

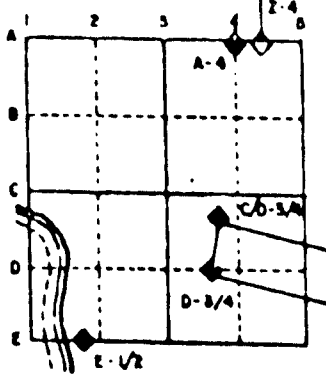

TORTLE TWP
ROCK COUNTY WI


IF AVAILABLE
STATE PLANE COORDINATES

North (Y) 222,184.50 Elevation (Z) _____
 East (X) 498,736.26 Zone _____
 Hor. Datum _____ Vert. Datum _____

◆ CORNER MONUMENT

○ WITNESS MONUMENT

BEARINGS ARE BASED ON:

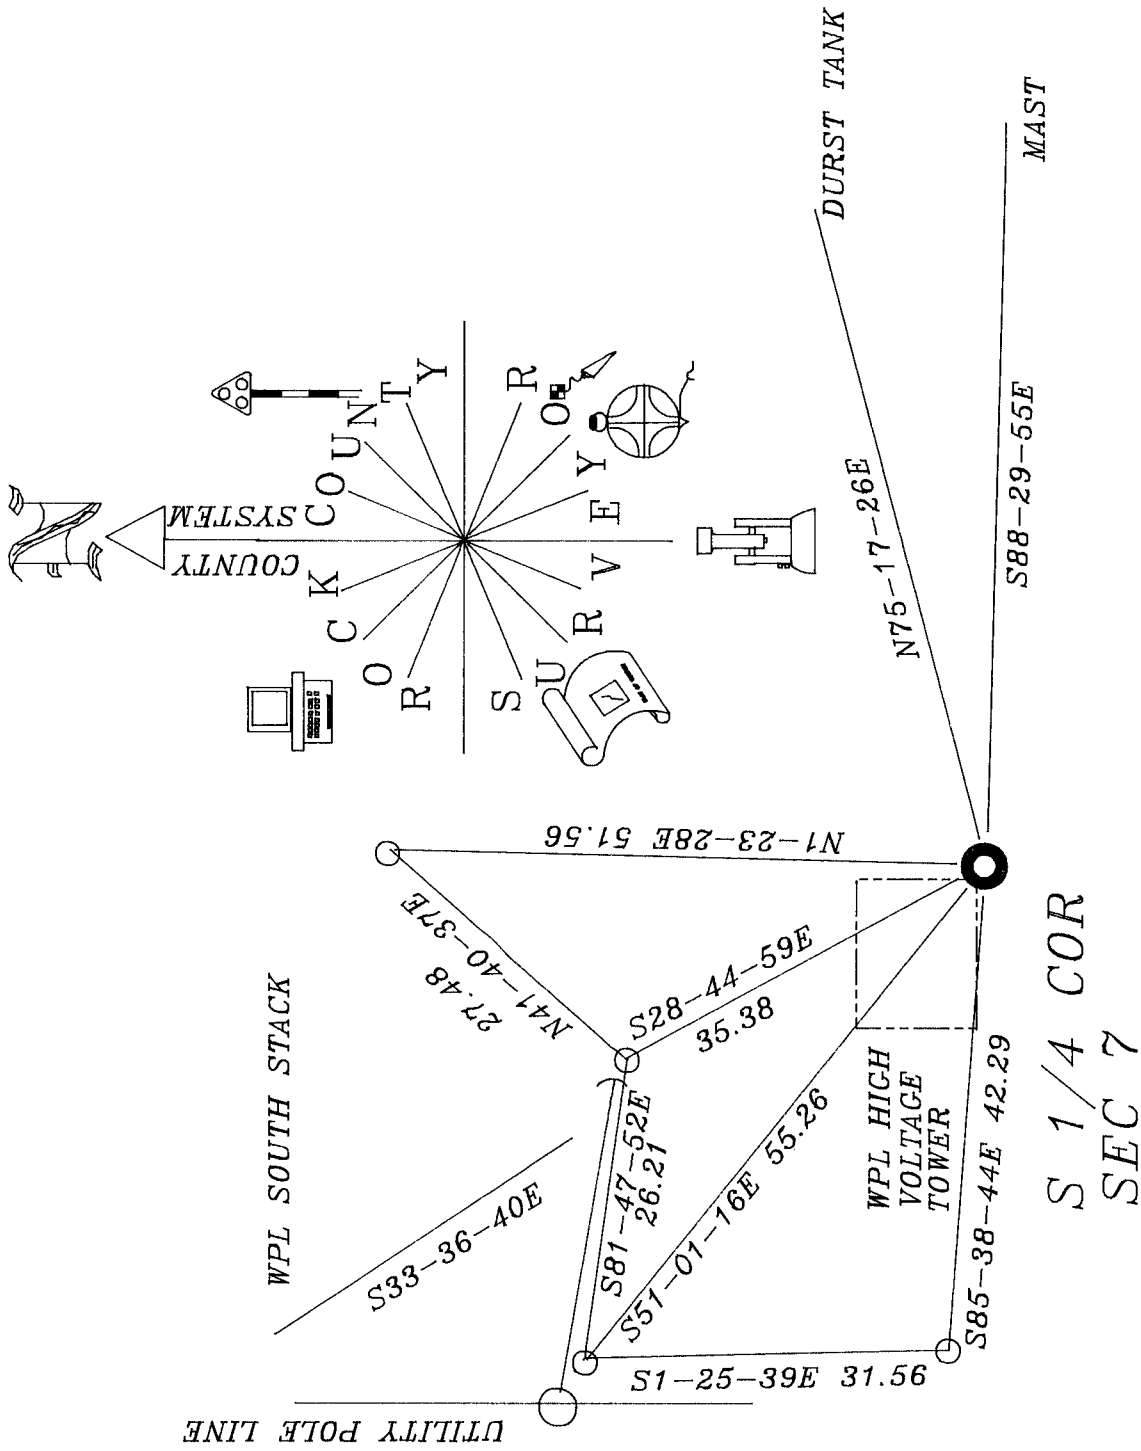

S 1/4 COR
SEC 7

- OBSERVATION SHEET #542
- 3/4X24 REROD WITH PLASTIC CAP
- FOUND 2" PIPE 1.4' EAST OF TOWER LEG, 0.6' SOUTH OF SOUTH FACE OF TOWER. PLACED CARBONITE POST

Donald Burns
b/p/95