

PUBLIC LAND SURVEY MONUMENT RECORD

For Public Land Survey Corners in the


T. 1 N., R. 13 E.

CORNER CODE INDEX

	1	2	3	4	5	6	7	8	9	10	11	12	13	14	15	16	17	18	19	20	21	22	23	24	25
A																									
B																									
C																									
D																									
E																									
F																									
G																									
H																									
I																									
J																									
K																									
L																									
M																									
N																									
O																									
P																									
Q																									
R																									
S																									
T																									
U																									
V																									
W																									
X																									
Y																									

PLACE MONUMENT SYMBOL (●) AT PROPER LOCATION ON ABOVE INDEX

EXAMPLE

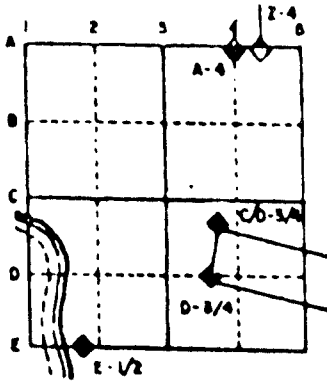

TURTLE TWP  
ROCK COUNTY WI

IF AVAILABLE  
STATE PLANE COORDINATES

North (Y) 216,728.68 Elev. (Z) \_\_\_\_\_  
East (X) 511,991.30 Zone \_\_\_\_\_  
Hor. Datum COUNTY Vert. Datum \_\_\_\_\_

◆ CORNER MONUMENT  
Fd DISK IN  
CONCRETE

○ WITNESS MONUMENT

FD DISK IN  
CONCRETE MON.

W 1/4 COR  
SEC 15

BEARINGS ARE BASED ON: COUNTY SYSTEM

S 1/4 COR SEC 16  
SE COR SEC 16  
FD POLY N88-37-29W 2659.16

S 1/4 COR SEC 15  
S88-34-13E 2647.48  
FD 1" PIPE

3/4X24 REROD  
/PLASTIC CAP  
STA 973

S15-39-06W 617.70

N0-21-01E 2661.18  
S0-00-15W 2656.23  
FD CI  
W 1/4 COR  
SEC 22

SHEET \_\_\_ OF \_\_\_

CORNER CODE: N13

TU567

(B) Describe any record evidence, monument evidence, occupational evidence, testimonial evidence or any other material evidence you considered, and whether the monument was found or placed.

1836 LYONS SET POST CORNER TO SECTIONS 15,16,21,&22 BUR OAK 25 N76E 20 & DOUBLE BUR OAK 10 N54E 92.

1966 BATTERMAN VOL 4 PG 250 DUG & FOUND 5/8X24 PIN REPLACED PIN WITH STANDARD CONCRETE SURVEY MONUMENT WITH BRASS CAP ON TOP. SHOWS MONUMENT 2 SOUTH OF E/W FENCE & 0.5 WEST OF N/S FENCE.

1972 LEE VOL 4 PG 585 CONCRETE MONUMENT. 2647.29 TO N 1/4 COR SEC 22,2656.19 TO W 1/4 COR SEC 22,ANGLE OF 88-34-30 FROM N 1/4 COR TO W 1/4 COR SEC 22,ANGLE OF 91-23-27 AT W 1/4 COR SEC 22 FROM NW TO E 1/4 COR SEC 22,& ANGLE OF 91-28-30 AT N 1/4 COR FROM S 1/4 TO NW CORNERS OF SEC 22.

1980 DOT VOL 6 PG 55&120 PROJECT 1093-02-85 CONCRETE MONUMENT. COORDINATES OF 198,241.91;2,282,081.99

FOUND DISK IN CONCRETE. 2647.48 (REC 2647.29) TO N 1/4 COR 22,2656.23 (REC 2656.19) TO W 1/4 COR SEC 22,ANGLE OF 88-34-28 (REC 88-34-30) AT NW COR SEC 22 FROM N 1/4 COR TO W 1/4 COR SEC 22,ANGLE OF 91-23-42 (REC 91-23-27) AT W 1/4 COR SEC 22 FROM N 1/4 TO E 1/4 COR SEC 22,ANGLE OF 91-28-20 (REC 91-28-30) AT N 1/4 COR SEC 22 FROM S 1/4 COR TO NW CORNERS OF SEC 22.

C) Was the corner restored through acceptance of (1) an obliterated evidence location, or, (2) a found perpetuated location?  
ACCEPTED FOUND PERPETUATED LOCATION.

D) Describe any material discrepancy between the location of the corner as restored or reestablished and the location of that corner as previously restored or reestablished by distance and direction. Show the discrepancy on the plan view drawing under (a), above. Show the distances between the corner as previously restored or reestablished and (1) the corner as restored or reestablished, and (2) to at least 4 of the witness monuments shown on the drawing in (a), above.

(E) Was the corner reestablished through lost corner proportionate methods? If so, show the method, including the directions and distances to other public land survey corners used as evidence or used for proportioning the corner location.  
NO

I, Donald Barnes, hereby certify that the corner points as identified by the corner code index were, in a field survey on,1995, established, re-established, monumented, re-monumented, recovered or restored as expressed below and in conformance with the regulations and rules as required in the current manual of survey instructions of the United States Department of Interior, Bureau of Land Management.

seal

7/14/95  
Donald Barnes

EMBOSS LAND SURVEYOR SEAL

COUNTY SURVEYOR FILING DATA

Date of computer entry \_\_\_\_\_

Date microfilmed \_\_\_\_\_

Number of included sheets \_\_\_\_\_

CORNER CODE

N13