

TU582

(B) Describe any record evidence, monument evidence, occupational evidence, testimonial evidence or any other material evidence you considered, and whether the monument was found or placed.

- 1836 LYONS SET QUARTER SECTION POST & MADE MOUND OF EARTH & SOD. CALLS FOR 2640 TO SE CORNER AND 2407.68 TO SW CORNERS OF SECTION 19.
- 1859 HOBART VOL 1 PG 105 OAK POST 6" SQUARE. LOCUST 3 S40E 78 & LOCUST 4 NORTH 331. 2412.96 S89-47W TO SW COR SEC 19 & 2640 N0-42E TO CENTER OF SECTION 19.
- 1885 RUGER VOL 2 PG 295 SET JOLIET LIMESTONE 18X7X6 HOLE 1/2" IN DIA. DRILLED IN TOP. 2651.22 (VAR 3-26) TO NE COR SEC 30, 2414.78 TO NW COR SEC 30, 2648.80 TO CENTER OF SEC 30, 2646.93 CENTER OF SEC 30 TO E 1/4 COR SEC 30, 2465.92 CENTER TO W 1/4 COR SEC 30. SET JULIET LIMESTONES AT 1/16TH CORNERS TO THE EAST & WEST OF THE S 1/4 COR OF SECTION 19.
- 1887 RUGER VOL 2 PG 414 STATED NOTHING ABOUT MONUMENT. 5283.63 TO N 1/4 COR SEC 19 & 2289.54 TO CENTER OF SHOPIER & BELOIT RD.
- 1911 KERCH VOL 3 PG 64 FOUND STONE SET BY RUGER. EAST 877.1 TO STONE SET BY RUGER & DROVE 2" GAS PIPE 36" AT THIS POINT. 2652.4 TO NE COR SEC 30 & 2650.1 TO E 1/4 COR SEC 30. ANGLE OF 90-40 AT THE NE COR SEC 30 FROM THE E 1/4 COR TO N 1/4 CORNERS OF SEC 19.
- 1911 KERCH VOL 3 PG 69 FOUND STONE SET BY RUGER. ANGLE OF 89-20-00 AT THE SW COR OF SEC 19 FROM THE W 1/4 TO S 1/4 CORNERS OF SECTION 19. 2426.9 FROM W 1/4 COR TO CENTER OF SEC 19 AND AN ANGLE OF 89-13 AT THE CENTER OF SEC 19 FROM THE N 1/4 TO E 1/4 CORNERS OF SECTION 30. 1911 KERCH PLAT 7 PG 47 STONE AT S 1/4 COR SEC 19. AN ANGLE OF 90-40 AT THE NE CORNER OF SEC 30 FROM THE E 1/4 COR TO THE N 1/4 CORNERS OF SEC 30. 2650.1 FROM THE NE COR TO E 1/4 CORNERS OF SEC 30.
- 1962 BATTERMAN PLAT 21 PG 20 SYMBOL SHOWS AN EXISTING CONCRETE MONUMENT. WEST 74.80 TO A PIPE, EAST 110.01 TO A PIPE, NORTH 150 TO A PIPE. SHOWS AN ELECTRIC TOWER TO THE NORTHEAST.
- 1974 LEE MAP #4805 FOUND 4" CONCRETE MONUMENT. EAST 365.01 TO IRON PIPE.
- 1976 COMBS PLAT 32 PG 10 FOUND 3/4" PIN.
- 1992 LEE PLAT 32 PG 134 EAST 396.96 TO PIPE. AT THE S 1/4 COR OF SEC 19 AN ANGLE OF 89-23-40 FROM CENTER OF SEC 19 TO THE PIPE.
- 1993 LUENBERGER PLAT 32 PG 179 STATES NOTHING ABOUT MONUMENT. 2697.59 TO CENTER OF SECTION 19.
- 1994 LEE PLAT 32 PG 203 FOUND 3/4" PIN.
- 1994 LUENBERGER PLAT 32 PG 206 FOUND 3/4" PIN. 2697.56 TO CENTER OF SECTION 19.

FOUND BENT 3/4X42" REROD ON EAST SIDE OF ROTTEN R/W POST. REPLACED WITH 3/4X24 REROD. 5287.80 (REC 5283.63) TO N 1/4 COR SEC 19, ANGLE OF 90-40-08 (REC 90-40) AT THE NE COR SEC 30 FROM THE E 1/4 COR TO N 1/4 CORNERS OF SEC 30. ANGLE OF 89-13-00 (REC 89-13) AT THE INTERSECTION OF THE 1/4 LINES IN SEC 19 FROM THE N 1/4 COR TO E 1/4 CORNERS OF SEC 19, & 2640.9999 (REC 2697.56) FROM THE S 1/4 COR TO THE INTERSECTION OF THE 1/4 LINES OF SECTION 19. THE PIN AT THE S 1/4 COR SEC 19 IS 5.36 NORTH OF A LINE BETWEEN THE SW AND SE CORNERS OF SECTION 19.

THE FOLLOWING ARE RECORD AND MEASURED DISTANCES.
FROM SW TO S 1/4 CORNERS OF SEC 19.

BARNES 1995	2415.39
BATTERMAN 1940 MAP # 4818	2415.55
RUGER 1885	2414.78
HOBART 1859	2412.96
LYONS 1836	2407.68

FROM THE S 1/4 TO THE SE CORNERS OF SEC 19

BARNES 1995	2651.46
KERCH 1911	2652.40
KERCH 1911	2649.60
RUGER 1885	2651.22
LYONS 1836	2640.00

Donald Barnes
6/12/95
R3

C) Was the corner restored through acceptance of (1) an obliterated evidence location, or, (2) a found perpetuated location?

ACCEPTED FOUND PERPETUATED LOCATION.

D) Describe any material discrepancy between the location of the corner as restored or reestablished and the location of that corner as previously restored or reestablished by distance and direction. Show the discrepancy on the plan view drawing under (a), above. Show the distances between the corner as previously restored or reestablished and (1) the corner as restored or reestablished, and (2) to at least 4 of the witness monuments shown on the drawing in (a), above.

(E) Was the corner reestablished through lost corner proportionate methods? If so, show the method, including the directions and distances to other public land survey corners used as evidence or used for proportioning the corner location.

NO

I, Donald Barnes, hereby certify that the corner points as identified by the corner code index were, in a field survey on 1994, established, re-established, monumented, re-monumented, recovered or restored as expressed below and in conformance with the regulations and rules as required in the current manual of survey instructions of the United States Department of Interior, Bureau of Land Management.

seal

Donald Barnes
6/12/95

EMBOSS LAND SURVEYOR SEAL

COUNTY SURVEYOR FILING DATA

Date of computer entry _____

Date microfilmed _____

Number of included sheets _____
CORNER CODE

XXXXXXXXXXXXXXXXXXXX

3/4X24 REROD
PLASTIC CAP

S28-19-59E
40.59

N1-29-28E 39.75

REC 70.00

00.07 REC S0-03-34E 69.81

N78-43-15E
20.61

3/4X24 REROD
PLASTIC CAP

WPL
ELECTRIC
TOWER

S60-47-38E 143.37

FD 1/2" PIN


S89-56-40E 125.02

FD 1/2" PIN

S54-48-38E 128.34

BAYLISS RD

SEE OBS. SHEET #811

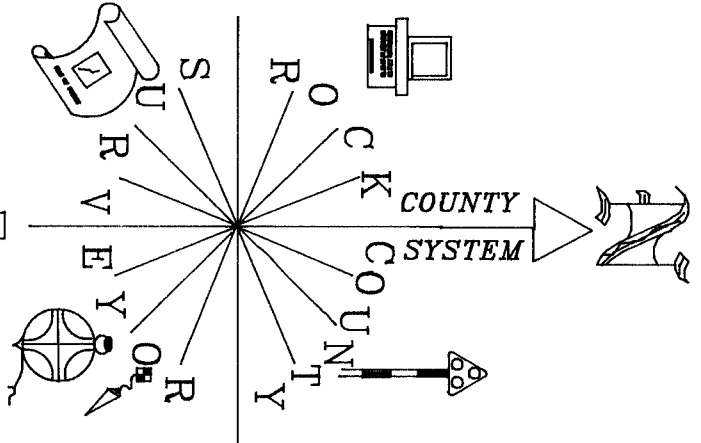

Donald Barnes
6/12/95

R3