

PUBLIC LAND SURVEY MONUMENT RECORD

For Public Land Survey Corners in the


T. 1 N., R. 13 E.

CORNER CODE INDEX

	1	2	3	4	5	6
A						
B	6	5	4	3	2	
C						
D						
E						
F						
G	7	8	9	10	11	12
H						
I						
J						
K						
L	18	17	16	15	14	13
M						
N						
O						
P	19	20	21	22	23	24
Q						
R						
S						
T	30	29	28	27	26	25
U						
V						
W						
X	31	32	33	34	35	36
Y						
Z						

PLACE MONUMENT SYMBOL (◆) AT PROPER LOCATION ON ABOVE INDEX

EXAMPLE

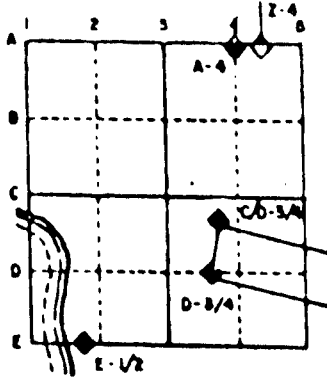

TURTLE TWP  
ROCK COUNTY WI

IF AVAILABLE  
STATE PLANE COORDINATES

North (Y) 22A, 419.17 Eleve. (Z) \_\_\_\_\_

East (X) 522, 667.46 Zone \_\_\_\_\_

Hor. Datum COUNTY Vert. Datum \_\_\_\_\_

◆ CORNER MONUMENT

○ WITNESS MONUMENT

BEARINGS ARE BASED ON:

(B) Describe any record evidence, monument evidence, occupational evidence, testimonial evidence or any other material evidence you considered, and whether the monument was found or placed.

- 1859 RUGER VOL 1 PG 93 CALLS FOR 2636.04 VAR 7-07 TO NE COR SEC 11.  
1864 LOCKE VOL 1 PG 207 FOUND STUMP OF S. BT. FOR POST RIGHT ON CORNER. CALLS FOR 2637.36 TO CENTER OF SEC 11 & 5274.72 TO W 1/4 COR SEC 11.  
1865 LOCKE VOL 1 PG 238 SEE PG 207. CALLS FOR 2670.62 TO SE COR SEC 11, 2629.70 TO NE COR SEC 11, & 2642.90 TO CENTER OF SEC 11.  
1903 KERCH VOL 3 PG 20 CALLS FOR 2661.6 TO SE COR SEC 11.  
1971 LEE VOL 4 PG 529 FOUND RED GRANITE STONE 18X10X10 DISTURBED NEAR OCCUPIED CORNER. MEASURED N, S, & W TO OCCUPIED CORNERS. FOUND DISTANCE WEST (2) 1/4 MILES TO CENTER 11, PROPORTIONATE BETWEEN FENCE ROWS, FOUND DISTANCES SOUTH COMPARABLE TO RECORD OF C.V. KERCH. FOUND OCCUPIED COR 11.00' W OF LINE BETWEEN SECTION CORNERS. BEING ALSO INDICATED BY AFORESAID KERCH SURVEY. SET C.I. AT OCCUPIED CORNER. CALLS FOR 2643.62 TO NW COR SEC 12 & 2660.73 TO SW COR SEC 12.  
1974 WIDOT VOL 6 PG 55 & 120 RED GRANITE STONE. NAD27 N/S 206,048.04; E/W 2,292,673.02.

FOUND CI. MONUMENT.

C) Was the corner restored through acceptance of (1) an obliterated evidence location, or, (2) a found perpetuated location?  
ACCEPTED FOUND PERPETUATED LOCATION.

D) Describe any material discrepancy between the location of the corner as restored or reestablished and the location of that corner as previously restored or reestablished by distance and direction. Show the discrepancy on the plan view drawing under (a), above. Show the distances between the corner as previously restored or reestablished and (1) the corner as restored or reestablished, and (2) to at least 4 of the witness monuments shown on the drawing in (a), above.

(E) Was the corner reestablished through lost corner proportionate methods? If so, show the method, including the directions and distances to other public land survey corners used as evidence or used for proportioning the corner location.  
NO

I, Donald Barnes, hereby certify that the corner points as identified by the corner code index were, in a field survey on, , established, re-established, monumented, re-monumented, recovered or restored as expressed below and in conformance with the regulations and rules as required in the current manual of survey instructions of the United States Department of Interior, Bureau of Land Management.

seal

*Donald Barnes* 7/13/95

COUNTY SURVEYOR FILING DATA

Date of computer entry \_\_\_\_\_

Date microfilmed \_\_\_\_\_

Number of included sheets \_\_\_\_\_

CORNER CODE

EMBOSS LAND SURVEYOR SEAL

A-E 7.08 REQUIREMENT

Donald Banes  
7/13/95

CENTER  
SEC 11

FD DISK IN  
CONCRETE

FD CI

NE COR  
SEC 11

N0-33-23E 2642.42

N88-46-09W 2664.38

E 1/4 COR  
SEC 11

FD CI S87-38-02E 5301.44

FD ALUM

E 1/4 COR  
SEC 12

S0-06-35W 2660.10

SE COR  
SEC 11 FD CI

