

PUBLIC LAND SURVEY MONUMENT RECORD

For Public Land Survey Corners in the


T. 1 N., R. 13 E.

CORNER CODE INDEX

	1	2	3	4	5	6	7	8	9	10	11	12	13	14	15	16	17	18	19	20	21	22	23	24	25
A																									
B	6	5	4	3	2																				
C																									
D																									
E																									
F																									
G	7	8	9	10	11	12																			
H																									
I																									
J																									
K																									
L	8	17	16	15	14	13																			
M																									
N																									
O																									
P	9	20	21	22	23	24																			
Q																									
R																									
S	50	29	28	27	26	25																			
T																									
U																									
V																									
W																									
X																									
Y	31	32	33	34	35	36																			

PLACE MONUMENT SYMBOL (●) AT PROPER LOCATION ON ABOVE INDEX

EXAMPLE

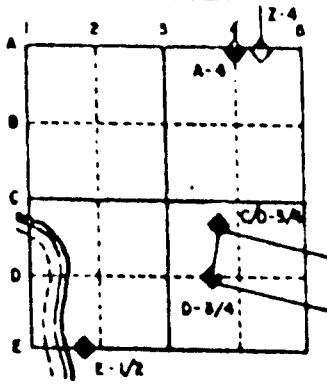

TURTLE TWP
ROCK COUNTY WI

IF AVAILABLE
STATE PLANE COORDINATES

North (Y) 221,759.07 Elev. (Z) _____
East (X) 522,662.36 Zone _____
Hor. Datum COUNTY Vert. Datum _____

◆ CORNER MONUMENT
Fd C.1

○ WITNESS MONUMENT

BEARINGS ARE BASED ON COUNTY SYSTEM

S 1/4 COR
SEC 11

N88-43-14W 2654.22

FD CI E 1/4 COR
SEC 11

NO-06-35E 2660.11

SE COR
SEC 11

S 1/4 COR
SEC 12

FD CI S88-53-18E 2647.91 FD ALUM.

S0-28-17W 2660.99

FD DISK
IN CONCRETE
E 1/4 COR
SEC 14

SHEET ___ OF ___

521

CORNER CODE

TU 551

(B) Describe any record evidence, monument evidence, occupational evidence, testimonial evidence or any other material evidence you considered, and whether the monument was found or placed.

- 1836 LYON SET POST CORNER TO SECTIONS 11,12,13,&14 BUR OAK 20 N51E 334 & BUR OAK 23 S14E 194
- 1865 LOCKE VOL 1 PG 238. FOUND STUMP OF S BT. 2646.60 TO S 1/4 COR SEC 11 & 2670.62 TO E 1/4 COR SEC 11.
- 1903 KERCH VOL 3 PG 20 FOUND CORNER SET BY LOCKE SET HH 20X16X14(MAYBE 19). 2661.6 TO E 1/4 COR SEC 11,2654.4 TO S 1/4 COR SEC 11,& 2661.6 TO E 1/4 COR SEC 14.
- 1914 COLDWELL VOL 3 PG 73 FOUND HARD HEAD STONE.
- 1969 BATTERMAN VOL 4 PG 406 1327.5 TO THE S 1/16 COR OF THE SE 1/4 OF SEC 11,1327.16 FROM THE S 1/16TH COR OF THE SE 1/4 OF SEC 11 TO THE N 1/4 COR OF SEC 14. FOUND STONE IN FENCE LINE 1.0 DEEP. SET C.I.
- 1969 BATTERMAN VOL 3 PG 20 FOUND STONE.
- 1970 BATTERMAN VOL 4 PG 475 FOUND HH AS SET AT SE COR SEC 11. SET 4"X30" CAST IRON MONUMENT.
- 1971 LEE VOL 4 PG 548 2654.32 TO N 1/4 COR SEC 14,2661.04 TO E 1/4 COR SEC 14,& AN ANGLE OF 90-48-23 FROM THE E 1/4 COR TO N 1/4 CORNERS OF SEC 14.
- 1971 LEE VOL 4 PG 529 SEE VOL 4 PG 475. 2660.73 TO W 1/4 COR SEC 12.

FOUND C.I.

C) Was the corner restored through acceptance of (1) an obliterated evidence location, or, (2) a found perpetuated location?

ACCEPTED FOUND PERPETUATED LOCATION

D) Describe any material discrepancy between the location of the corner as restored or reestablished and the location of that corner as previously restored or reestablished by distance and direction. Show the discrepancy on the plan view drawing under (a), above. Show the distances between the corner as previously restored or reestablished and (1) the corner as restored or reestablished, and (2) to at least 4 of the witness monuments shown on the drawing in (a), above.

(E) Was the corner reestablished through lost corner proportionate methods? If so, show the method, including the directions and distances to other public land survey corners used as evidence or used for proportioning the corner location.

NO

I, Donald Barnes, hereby certify that the corner points as identified by the corner code index were, in a field survey on,1994, established, re-established, monumented, re-monumented, recovered or restored as expressed below and in conformance with the regulations and rules as required in the current manual of survey instructions of the United States Department of Interior, Bureau of Land Management.

seal

Donald Barnes 7/15/95

EMBOSS LAND SURVEYOR SEAL

COUNTY SURVEYOR FILING DATA

Date of computer entry _____

Date microfilmed _____

Number of included sheets _____
CORNER CODE