

PUBLIC LAND SURVEY MONUMENT RECORD


For Public Land Survey Corners in the
T. 1 N., R. 13 E.

CORNER CODE INDEX

	1	2	3	4	5	6	7	8	9	10	11	12	13	14	15	16	17	18	19	20	21	22	23	24	25
A																									
B																									
C																									
D																									
E																									
F																									
G																									
H																									
I																									
J																									
K																									
L																									
M																									
N																									
O																									
P																									
Q																									
R																									
S																									
T																									
U																									
V																									
W																									
X																									
Y																									
Z																									

PLACE MONUMENT SYMBOL (◆) AT PROPER LOCATION ON ABOVE INDEX

EXAMPLE

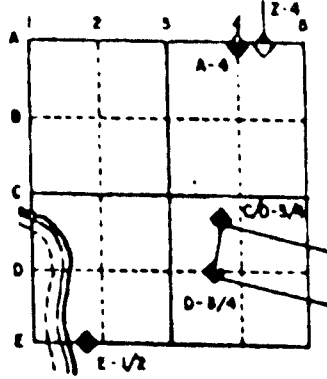

TURTLE TWP
ROCK COUNTY WI

IF AVAILABLE
STATE PLANE COORDINATES

North (Y) 21, 147.15 Elevation (Z) _____
 East (X) 522, 617.95 Zone _____
 Hor. Datum COUNTY Vert. Datum _____

◆ CORNER MONUMENT
Fd STONE IN
MON BOX

○ WITNESS MONUMENT

Fd TIES IN Vol 4 PG 396

BEARINGS ARE BASED ON:

(B) Describe any record evidence, monument evidence, occupational evidence, testimonial evidence or any other material evidence you considered, and whether the monument was found or placed.

1869 LEE VOL 1 PG 349 2658.48 TO N 1/4 COR SEC 25.
1869 LEE VOL 1 PG 350 2658.48 TO S 1/4 COR SEC 24, 2645.94 VAR 6-45 TO W 1/4 COR SEC 24.
1876 RUGER VOL 2 PG 215 FOUND STAKE SURROUNDED BY 3 HH STONES. ALSO FOUND DECAYED STUMPS OF BOTH BTs STAKE CORRECT. 2645.94 TO W 1/4 COR SEC 24.
1968 BATTERMAN VOL 4 PG 396 LEE FOUND POINTED HH SURROUNDED 4 SMALL HH AT SE COR & REFERENCED SAME.
1976 BARNES VOL 5 PG 220 2659.30 TO S 1/4 COR SEC 24.
1980 BARNES MON BOX. 2654.55 TO W 1/4 COR SEC 25 & AN ANGLE OF 87-52-19 FROM N 1/4 COR TO W 1/4 COR SEC 25.

FOUND STONE IN MON. BOX & TIES IN VOL 4 PG 396. 2640.52 TO W 1/4 COR SEC 24, 2659.37 (REC 2659.30) TO S 1/4 COR SEC 24, 2661.60 TO S 1/4 COR SEC 23, 2654.38 (REC 2654.55) TO W 1/4 COR SEC 25, AN ANGLE OF 87-52-22 (REC 87-52-19) FROM N 1/4 COR TO W 1/4 COR SEC 25.

C) Was the corner restored through acceptance of (1) an obliterated evidence location, or, (2) a found perpetuated location?
ACCEPTED FOUND PERPETUATED LOCATION.

D) Describe any material discrepancy between the location of the corner as restored or reestablished and the location of that corner as previously restored or reestablished by distance and direction. Show the discrepancy on the plan view drawing under (a), above. Show the distances between the corner as previously restored or reestablished and (1) the corner as restored or reestablished, and (2) to at least 4 of the witness monuments shown on the drawing in (a), above.

(E) Was the corner reestablished through lost corner proportionate methods? If so, show the method, including the directions and distances to other public land survey corners used as evidence or used for proportioning the corner location.

NO

I, Donald Barnes, hereby certify that the corner points as identified by the corner code index were, in a field survey on, 1994, established, re-established, monumented, re-monumented, recovered or restored as expressed below and in conformance with the regulations and rules as required in the current manual of survey instructions of the United States Department of Interior, Bureau of Land Management.

seal

Donald Barnes

EMBOSS LAND SURVEYOR SEAL

7/14/95

COUNTY SURVEYOR FILING DATA

Date of computer entry _____

Date microfilmed _____

Number of included sheets _____

CORNER CODE

A-E 7.08 REQUIREMENT

R21