

# PLAT AND RECORD

Of a Survey on Section 15 T 1N R 14 E. of the 4 P. M. in CLINTON Township

Rock County, Wisconsin, made APRIL the 14 1967


I hereby certify that the following is a correct record of said survey as made by me.

COUNTY BUILDING  
IN CITY OF BELOIT

*R. B. Bateman Jr.*

County Surveyor.

THE GEO. G. BARNARD COMPANY, ST. LOUIS

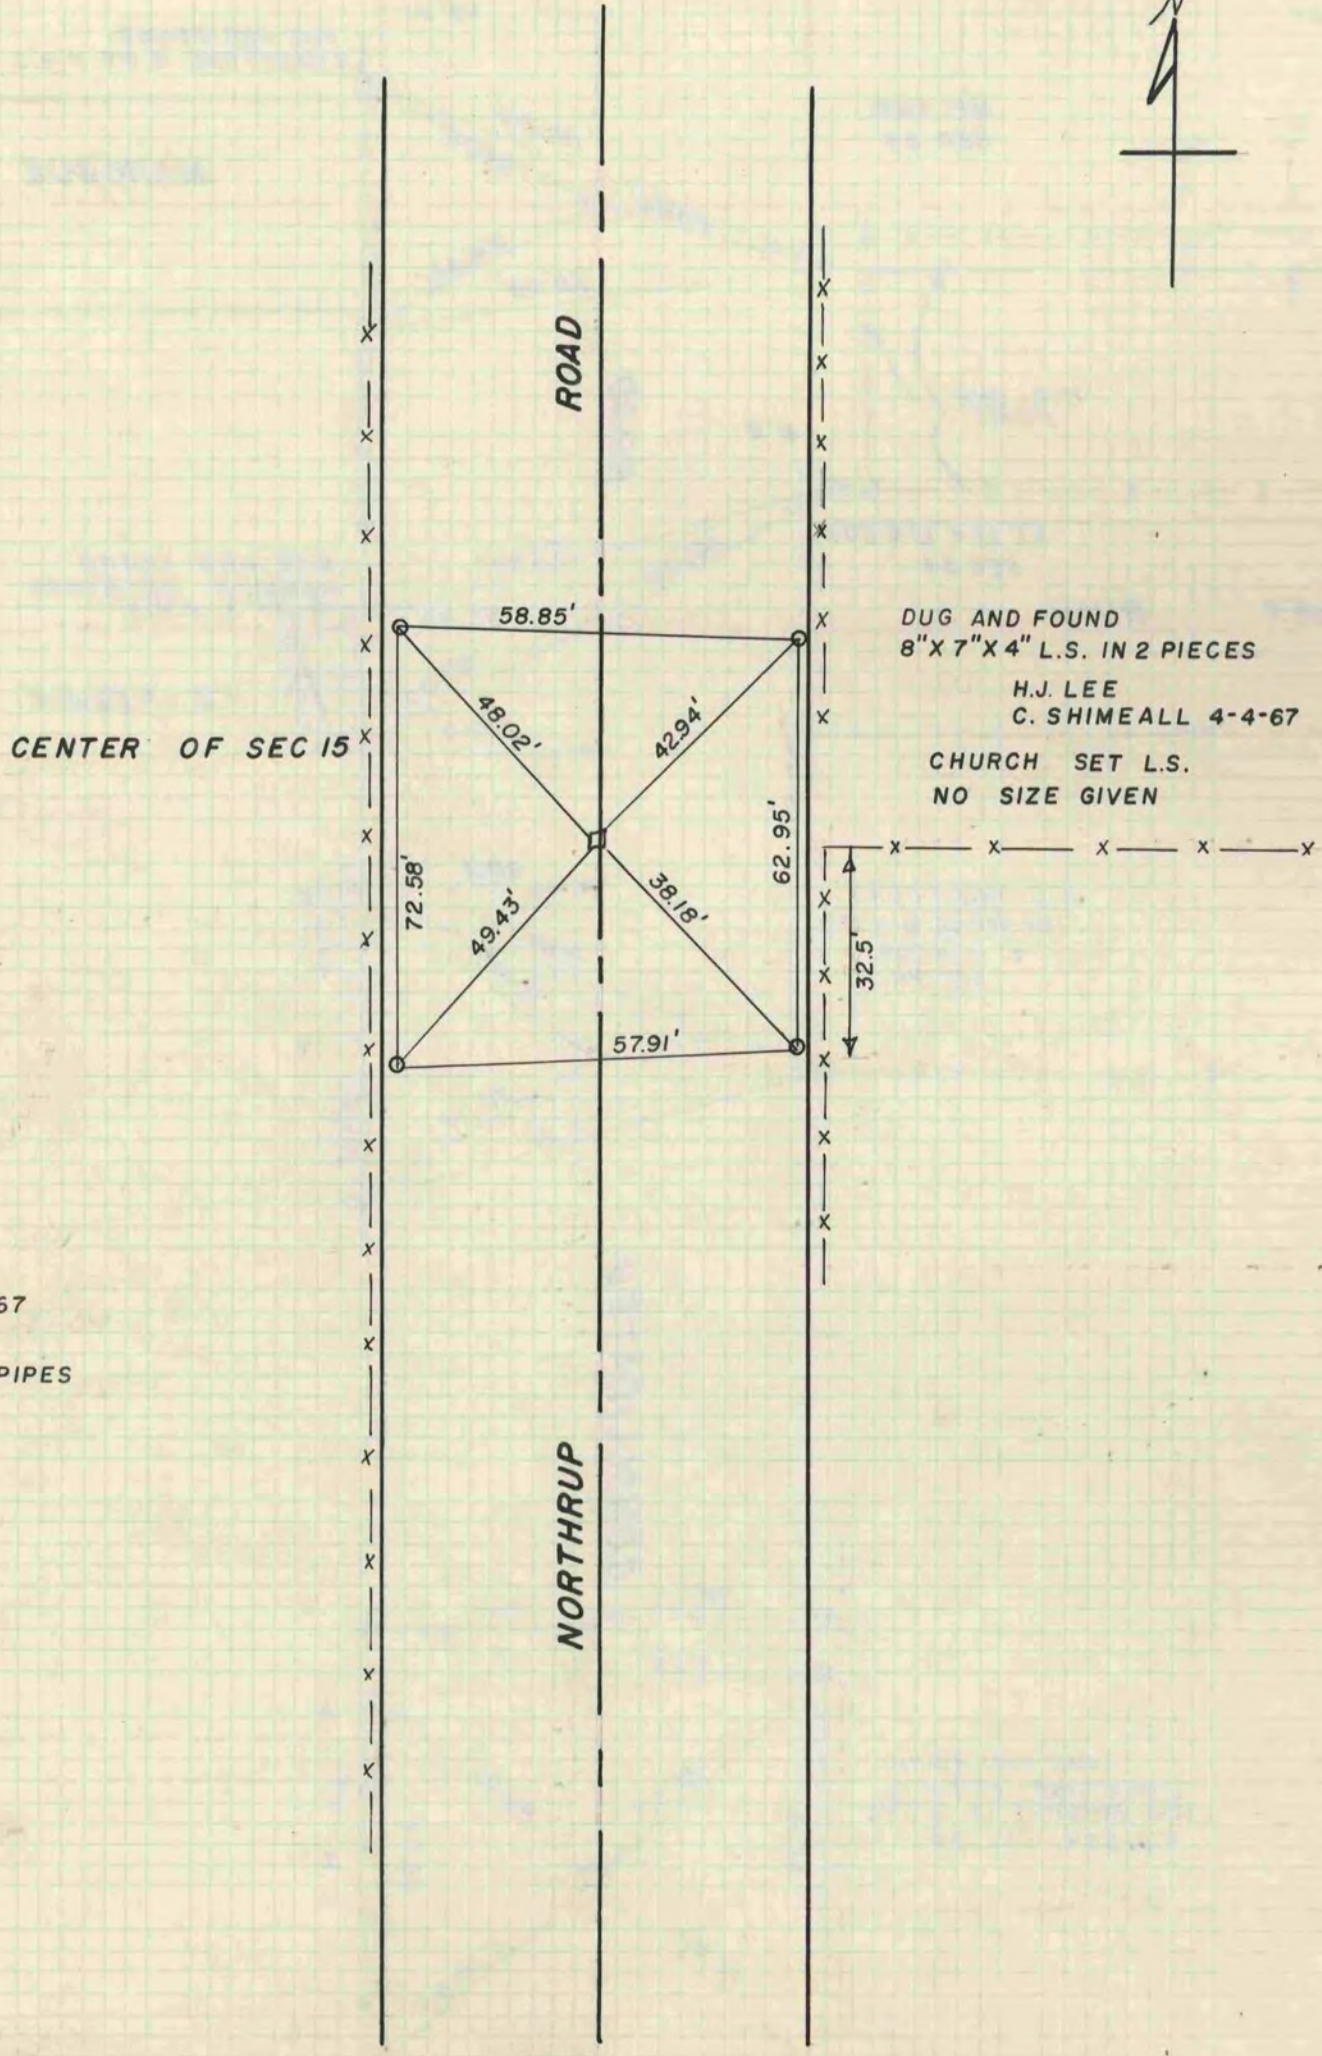

REF.

T. K.  
O.S.

4-14-67

0 = 1" IRON PIPES