

PLAT AND RECORD

Of a Survey on Section 19 T 4 R 12 E. of the 4 P. M. in Fulton Township

Rock County, Wisconsin, made August the 18+19 1875

I hereby certify that the following is a correct record of said survey as made by me.

(Signed) *Edward Roger*
R.R.B.

County Surveyor.


Found stump of N.E. B.T. where stump of S.W. B.T. had been dug up. Drove stake & Oil by 4 stones.

Found old stake of Cor. Also found N.W. B.T. & stump of S.W. B.T. Drove new stake in place of old one & Oil by 1 stone & 3 B.T. H.S.

Found remains of old stake of Cor. Also found stump of N.W. B.T. where stump of S.W. B.T. had been dug up. Drove new stake in place of old one & Oil by 1 N.H. & 3 Hones stones.

Found stump of S.E. B.T. where stump of N.E. B.T. had been dug up. Did not set Cor.

COUNTY BUILDING
IN CITY OF BELOIT

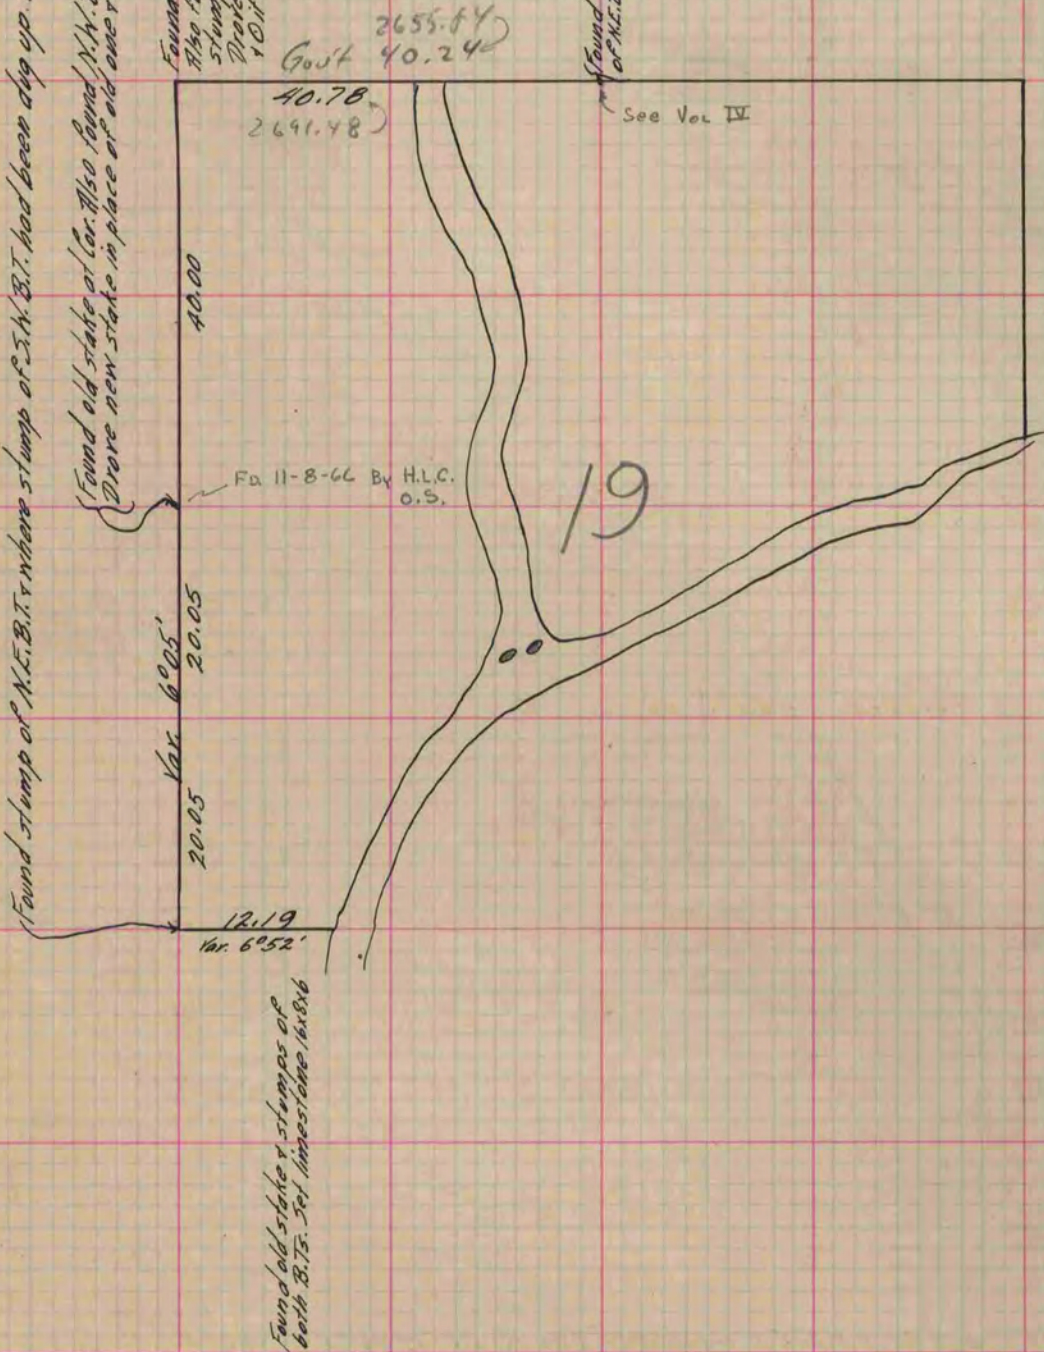

Copied from P. 154 Vol. 2 Original County Surveyors Record