

PLAT AND RECORD

Of a Survey on Section 12 T 2 R 11 E. of the 4 P. M. in Plymouth Township


Rock County, Wisconsin, made June the 20th 1867

I hereby certify that the following is a correct record of said survey as made by me.

COUNTY BUILDING
IN CITY OF BELOIT

(Signed) R. K. Lee
RKL

Deputy County Surveyor.

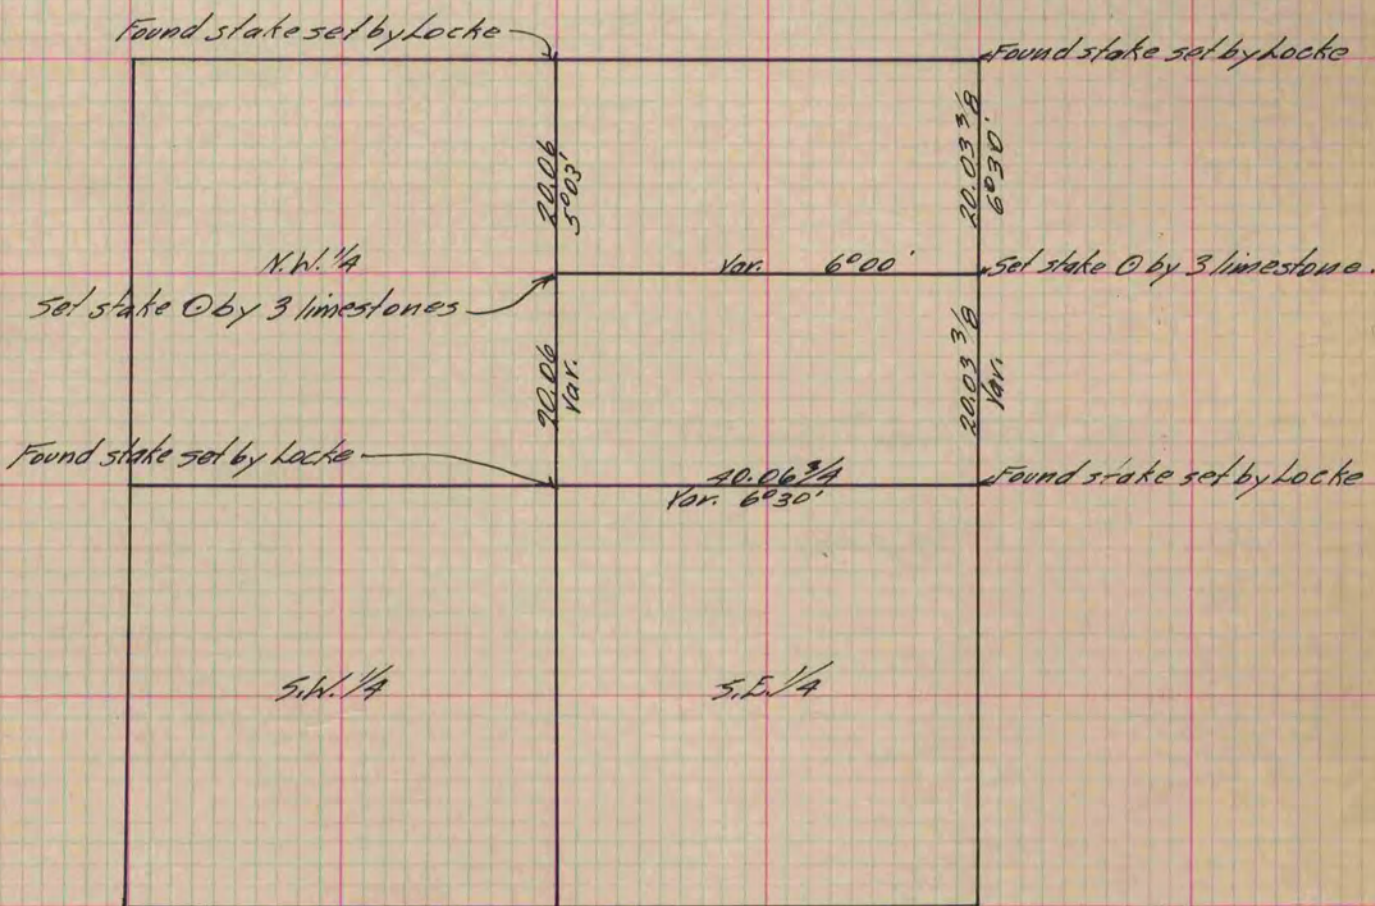

Copied from P. 272 Vol. 1 County Surveyor's Record.