

# PLAT AND RECORD

Of a Survey on Section 3 T 3 R 10 E. of the 4 P. M. in Magnolia Township


Rock County, Wisconsin, made December the 19<sup>th</sup> 1863

I hereby certify that the following is a correct record of said survey as made by me.

COUNTY BUILDING  
IN CITY OF БЕЛОIT

(Signed) S. D. Locke  
S. D. Locke

County Surveyor.

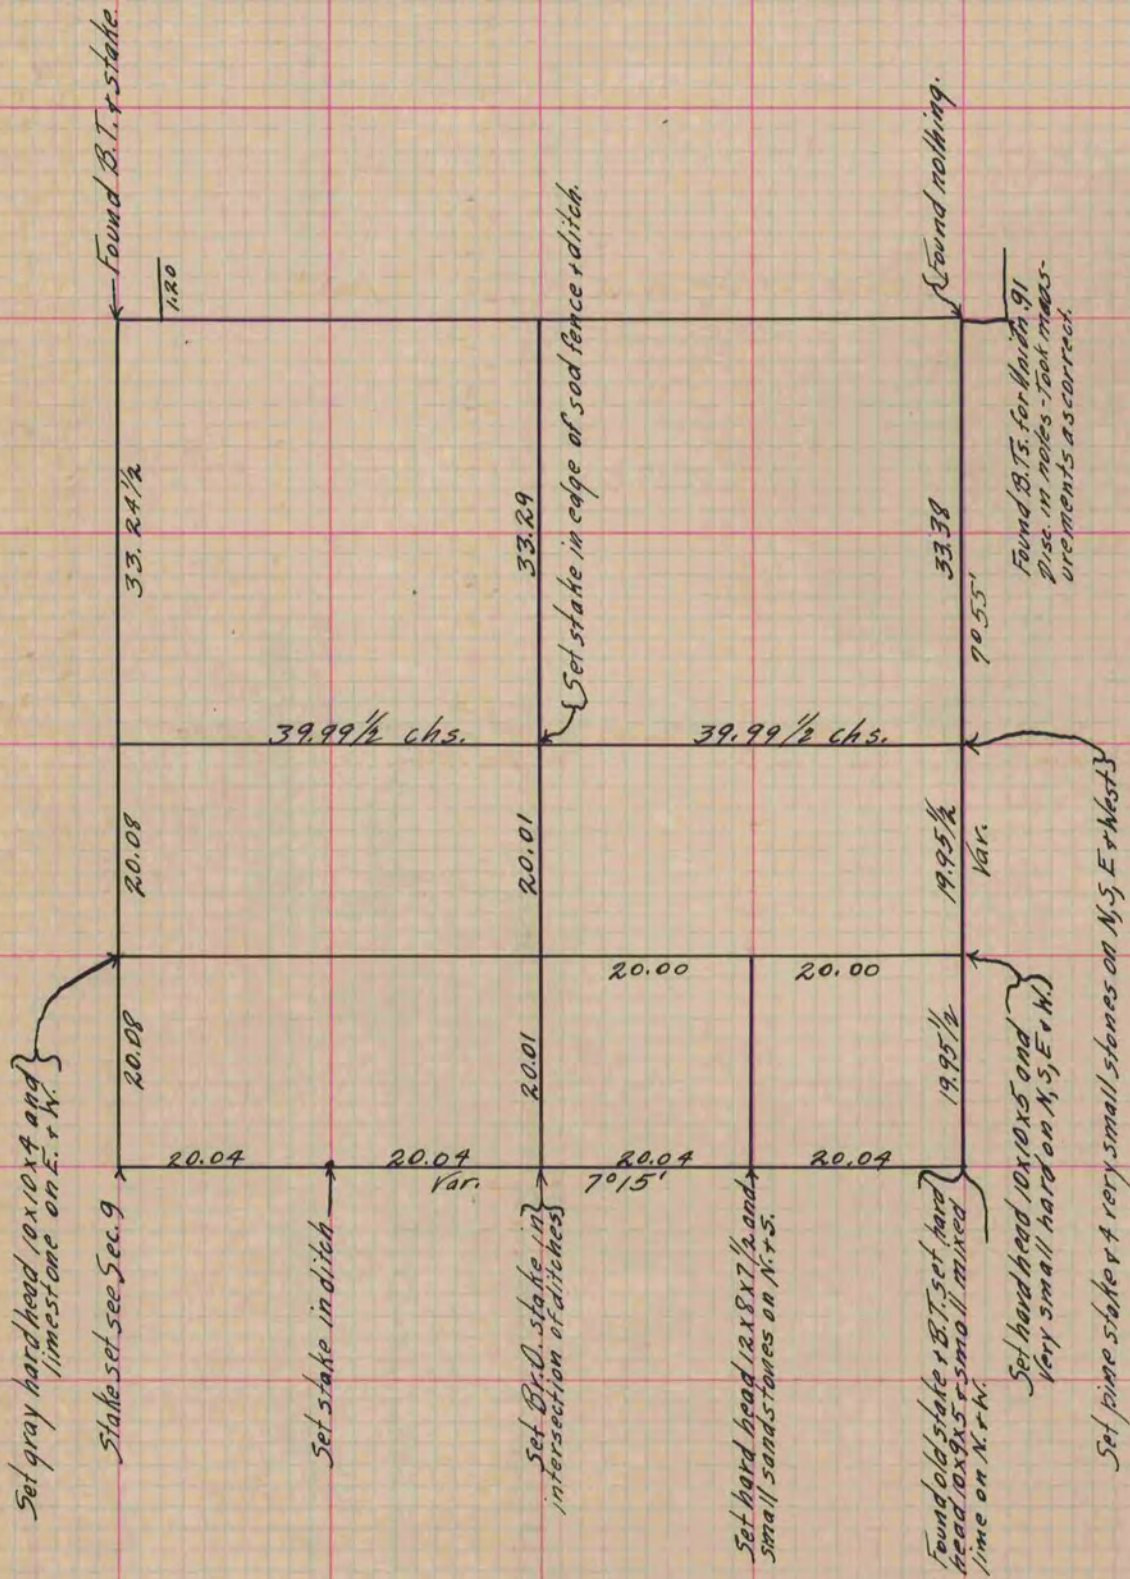

Copied from lower 1/2 of Page 197 Vol. 1. Original County Surveyor's Record.